

**21503010020**

I, Gary L. Dechant, do hereby certify that on the 18th day of April 19 84, I found (evidence) ~~(no evidence)~~ of the N $\frac{1}{2}$  corner of Section 12, T 15 N, R 3 W Fourth Principal Meridian, and I re-established said corner according to the Wisconsin Statutes as shown and described hereon.

History of corner establishment since Original Government Survey  
Webster Kenyon was here in November of 1891.




Dated this 22nd day of April 1984.  
Gary L. Dechant  
Reg. Land Surveyor, S-1744  
Title

Description of corner evidence found:

Accepted occupied corner as the best available evidence of the corner as it fits original government distance to the NE corner of Section 12 within 4'  $\pm$ .

Description of corner and witness monuments, references and accessories used to perpetuate the original or re-established location of this corner:

Witnesses to corner location:  
Lawrence A. Feddersen, SS#1226  
Gary L. Dechant

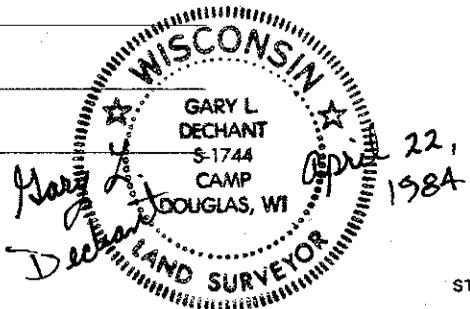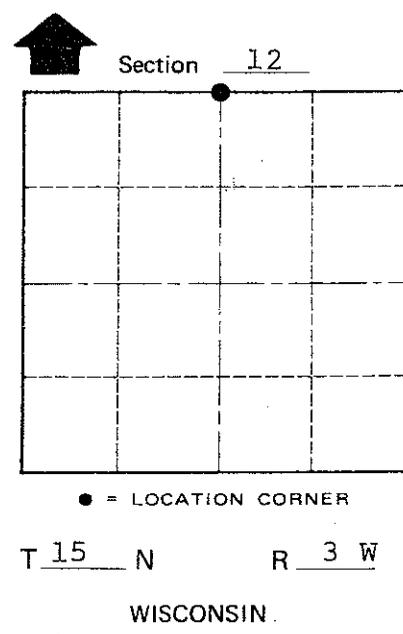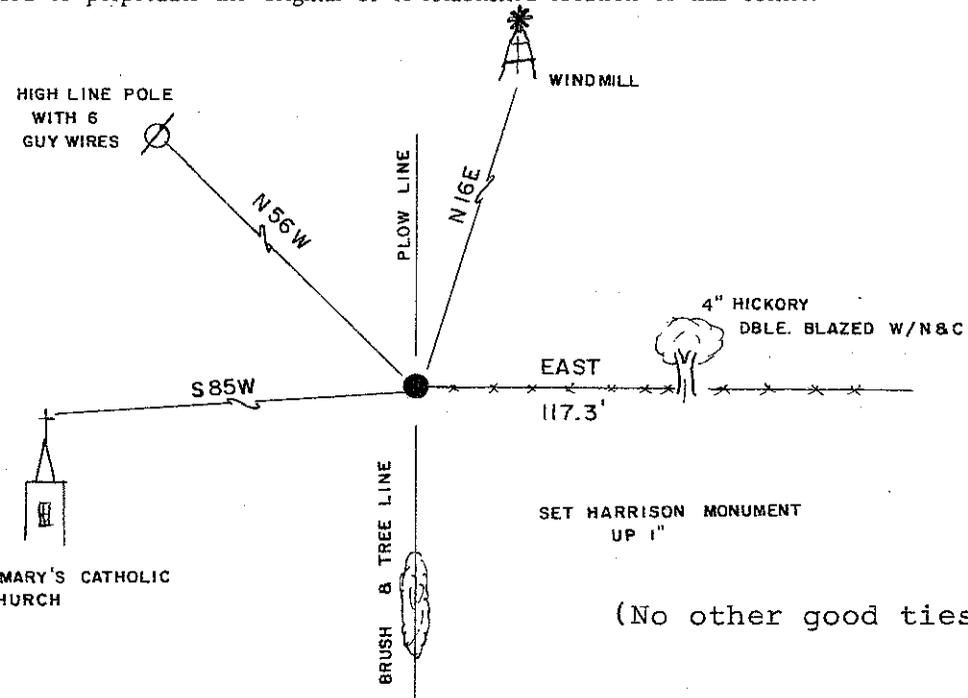

(No other good ties in the area)

COUNTY SURVEYOR FORM NO. 1

SURVEY CONTROL ORDER

Horizontal	_____
Vertical	_____

WISCONSIN COORDINATE SYSTEM

Corner	East (X)	North (Y)	Elevation (Z)	Zone
Control Sta. Name				

City, Village or Town Jefferson  
County of Monroe