

21503022000

I, Bryan H. Meyer, do hereby certify that on the 4th day of May 1989, I found (evidence) ~~no evidence~~ of the West 1/4 corner of Section 1, T 15 N, R 3 W Fourth Principal Meridian, and I re-established said corner according to the Wisconsin Statutes as shown and described hereon.

Dated this 6th day of July 1989.

Bryan H. Meyer

Registered Land Surveyor
Title

History of corner establishment since Original Government Survey

Webster Kenyon was here in June of 1894.

Description of corner evidence found:

I accepted the intersection of down fences from the South and East as the best available evidence.



COUNTY SURVEYOR FORM NO. 1

Description of corner and witness monuments, references and accessories used to perpetuate the original or re-established location of this corner:

Crew: Forsythe, Kenworthy
Date: May 4, 1989
Weather: Rain, Windy, 50°±
Witnesses to corner location:

Brian Forsythe

John Kenworthy

Bryan H. Meyer

H. A. SIME & ASSOC.

Surveying & Land Planning



1819 Stoughton Ave. - P.O. Box 705
TOMAH, WI 54660
608-372-5392

SURVEY CONTROL ORDER

Horizontal	_____
Vertical	_____

WISCONSIN COORDINATE SYSTEM

Corner	East (X)	North (Y)	Elevation (Z)	Zone
Control Sta. Name				

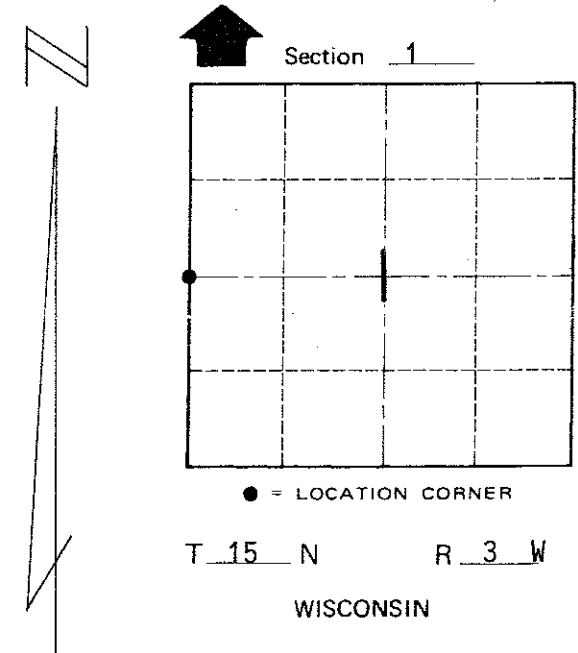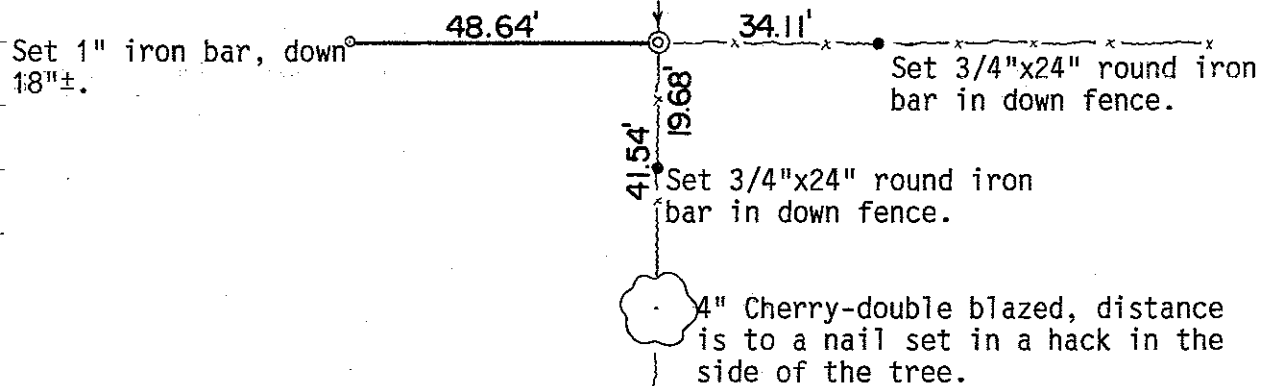

~~City, Village or~~ Town of Jefferson
County of Monroe