

**U.S. PUBLIC LAND CORNER
MAINTENANCE**

15

Corner ID: E1/4 Sec. 6, T15N-R3W
21503062000

<u>DATE</u>	<u>CREW</u>	<u>MONUMENT INFO</u>
March 24, 2020	Al Hoff Gary L. Dechant	Existing Harrison, down 3", 7' south center of CTH "F", 90' west of west end of bridge.

	<u>Bearing</u>	<u>Distance</u>
1) Set 3/4"x24" round iron bar, north shoulder of CTH "F"	N35°26'57"E	34.48'
2) Existing cap in SW corner of newer bridge wing	S84°03'24"E	90.89'
3) Existing 11/16" iron bar in Holden's 1903 thimble in south shoulder of "F"	S2°23'08"W	12.54' (12.54')
4) Set 3/4"x24" round iron bar, north shoulder of CTH "F"	N41°29'45"W	36.70'



March 31, 2020

CERTIFICATE

CERTIFIED LAND CORNER

I, Garold A. Sime, do hereby certify that on the 8th day of June 1984, I found ~~(witness)~~ ~~(or)~~ evidence of the E 1/4 corner of Section 6, T15 N, R 3 W, Fourth Principal Meridian, and I re-established said corner according to the Wisconsin Statutes as shown and described hereon.

Dated this 28th day of Sept. 1984.

Garold A. Sime

Garold A. Sime, R.L.S. 1261

History of corner establishment since Original Government Survey

Fred Holden was at this corner in April of 1903 and set an iron thimble 19 lks. South of corner. He was also here in Sept. of 1910. W.H. Sheldon was at this corner in 1878 in surveying the plat of Melvina. There was also another surveyor (Schroeder?) here April 22, ?

Description of corner evidence found:

Set this corner 19 lks. north of Holdens iron thimble.

See Reverse Side For Maintenance

COUNTY SURVEYOR FORM NO. 1



Description of corner and witness monuments, references and accessories used to perpetuate the original or re-established location of this corner:

Set Harrison Monument at corner

Witnesses to corner location:

G.A. Sime

Dallas Wilhite

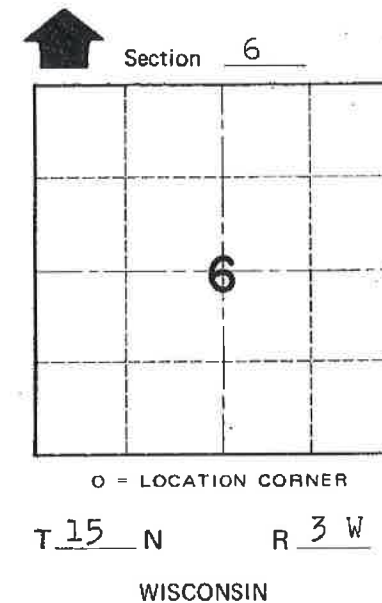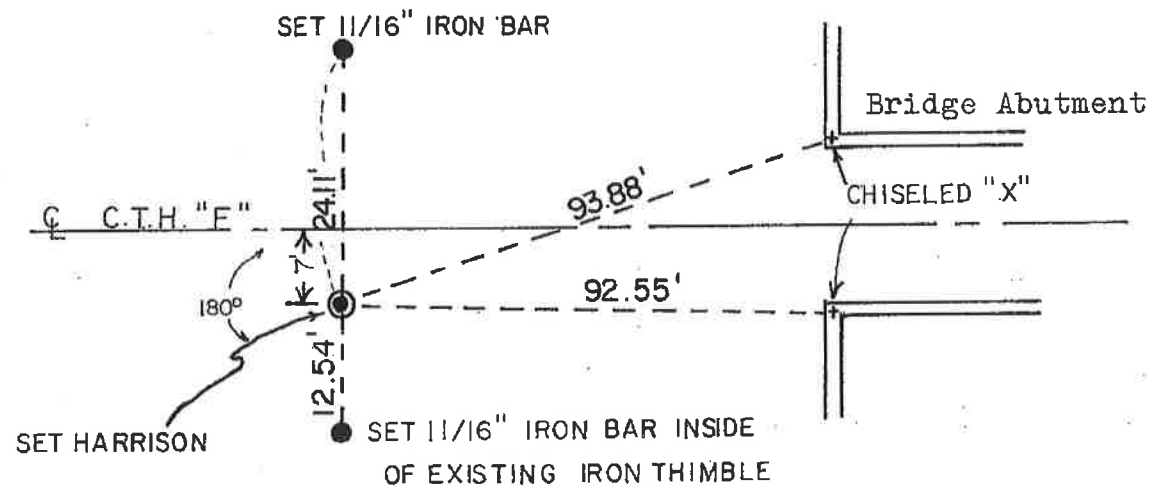

SIGN PLACED 3-29-90 J.S.S.

SURVEY CONTROL ORDER

Horizontal _____
Vertical _____

WISCONSIN COORDINATE SYSTEM

Corner	East (X)	North (Y)	Elevation (Z)	Zone
Control Sta. Name				

City, Village or Town Jefferson
County of Monroe