

21503102000

I, Lawrence A. Feddersen, do hereby certify that on the 28th day of april 19 78, I found (evidence) (~~XXXXXX~~) of the E 1/2 corner of Section 10, T 15 N, R 3W ~~XX~~ Fourth Principal Meridian, and I re-established said corner according to the Wisconsin Statutes as shown and described hereon.

Dated this 22 day of MAY 1978.

Lawrence A. Feddersen

REGISTERED LAND SURVEYOR, S-1226

Title

History of original corner establishment:

This corner was established or visited by Kenyon in 1891 and at which time he made a bearing tree; Schroeder re-established this corner with a post some time afterwards and used Kenyon's bearing tree; Holden visited this corner in 1908.

Description of corner evidence found:

This corner was established at the intersection of an old fence South and an ancient fallen fence West, as it was considered the best available evidence. Measurements 1/2 mile North and South agree with the Government notes and nearly as well with Schroeder's record distance for the East line of Sec. 10.



COUNTY SURVEYOR FORM NO. 1

Description of corner and witness monuments, references and accessories used to perpetuate the original or re-established location of this corner:

Witnesses to corner location:

Lawrence A. Feddersen

Douglas J. Malliet

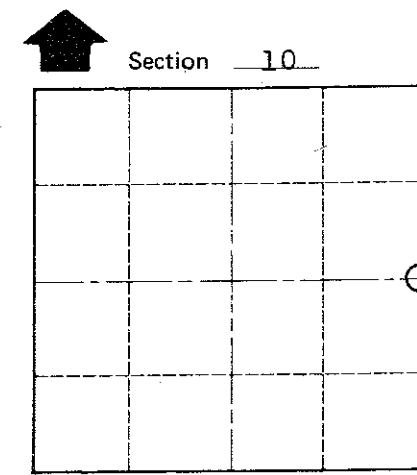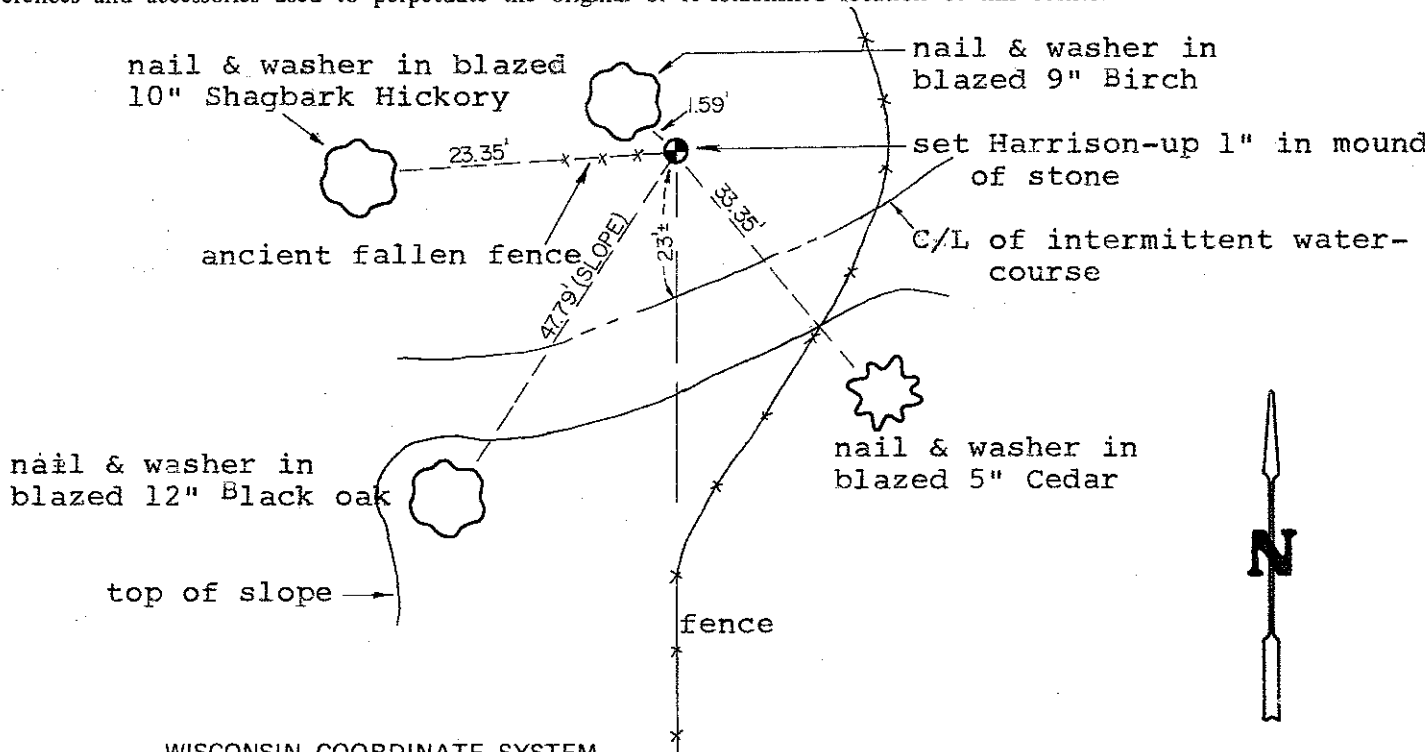

SURVEY CONTROL ORDER

Horizontal	_____
Vertical	_____

WISCONSIN COORDINATE SYSTEM

Corner	East (X)	North (Y)	Elevation (Z)	Zone
Control Sta. Name				

City, Village or Town of JEFFERSON

County of MONROE