

CERTIFICATE

CERTIFIED LAND CORNER

No. 101

21503250000

I, Mark R. Heidecke, do hereby certify that on the 6 day of February 19 79, I found (no evidence) of the Southeast corner of Section 25, T 15 N, R 3W E, Fourth Principal Meridian, and I re-established said corner according to the Wisconsin Statutes as shown and described hereon.

Dated this 23 day of May 19 79.

Mark R. Heidecke

Registered Land Surveyor Title



Description of corner evidence found:



The corner found in 1899 was not found. A Harrison monument was set at this corner at the intersection of old fences to the South and West with a recent fence to the North.

Description of corner and witness monuments, references and accessories used to perpetuate the original or re-established location of this corner:

Witnesses to corner location:

Mark R. Heidecke

Lawrence A. Feddersen

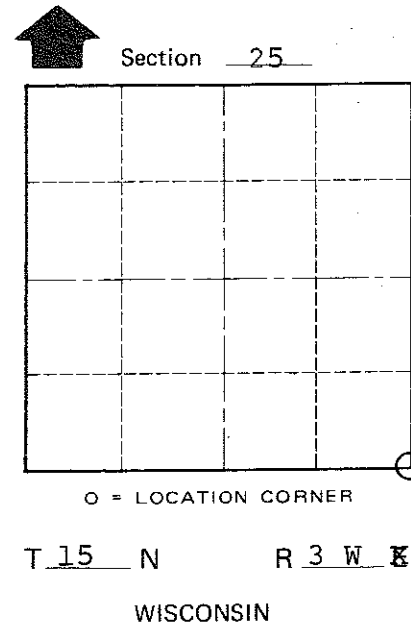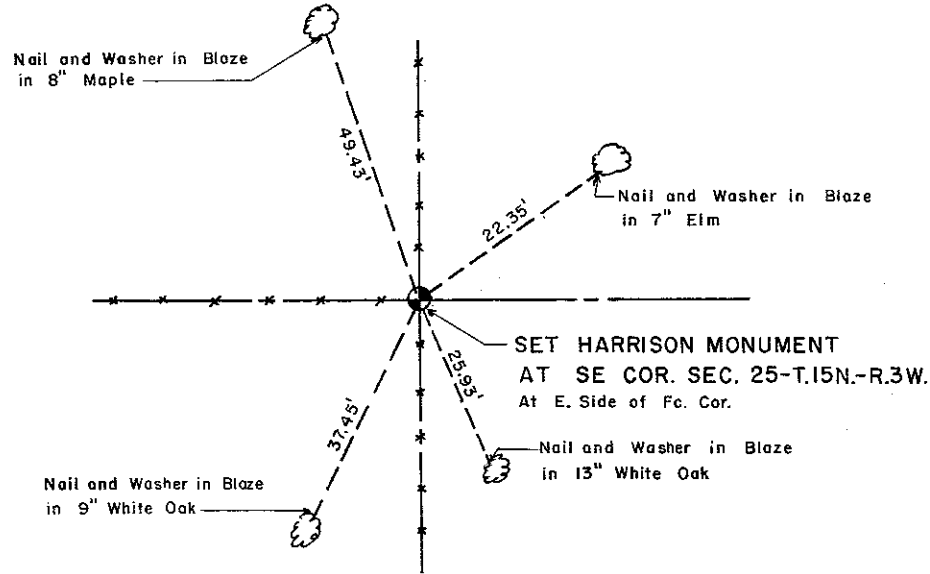

COUNTY SURVEYOR FORM NO. 1

SURVEY CONTROL ORDER

Table with 2 rows: Horizontal, Vertical.

WISCONSIN COORDINATE SYSTEM

Table with 5 columns: Corner, East (X), North (Y), Elevation (Z), Zone. Row 1: Control Sta. Name.

XXXXXX Town of Jefferson

County of Monroe