
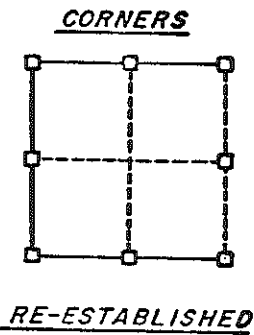


NOTES 52 .36

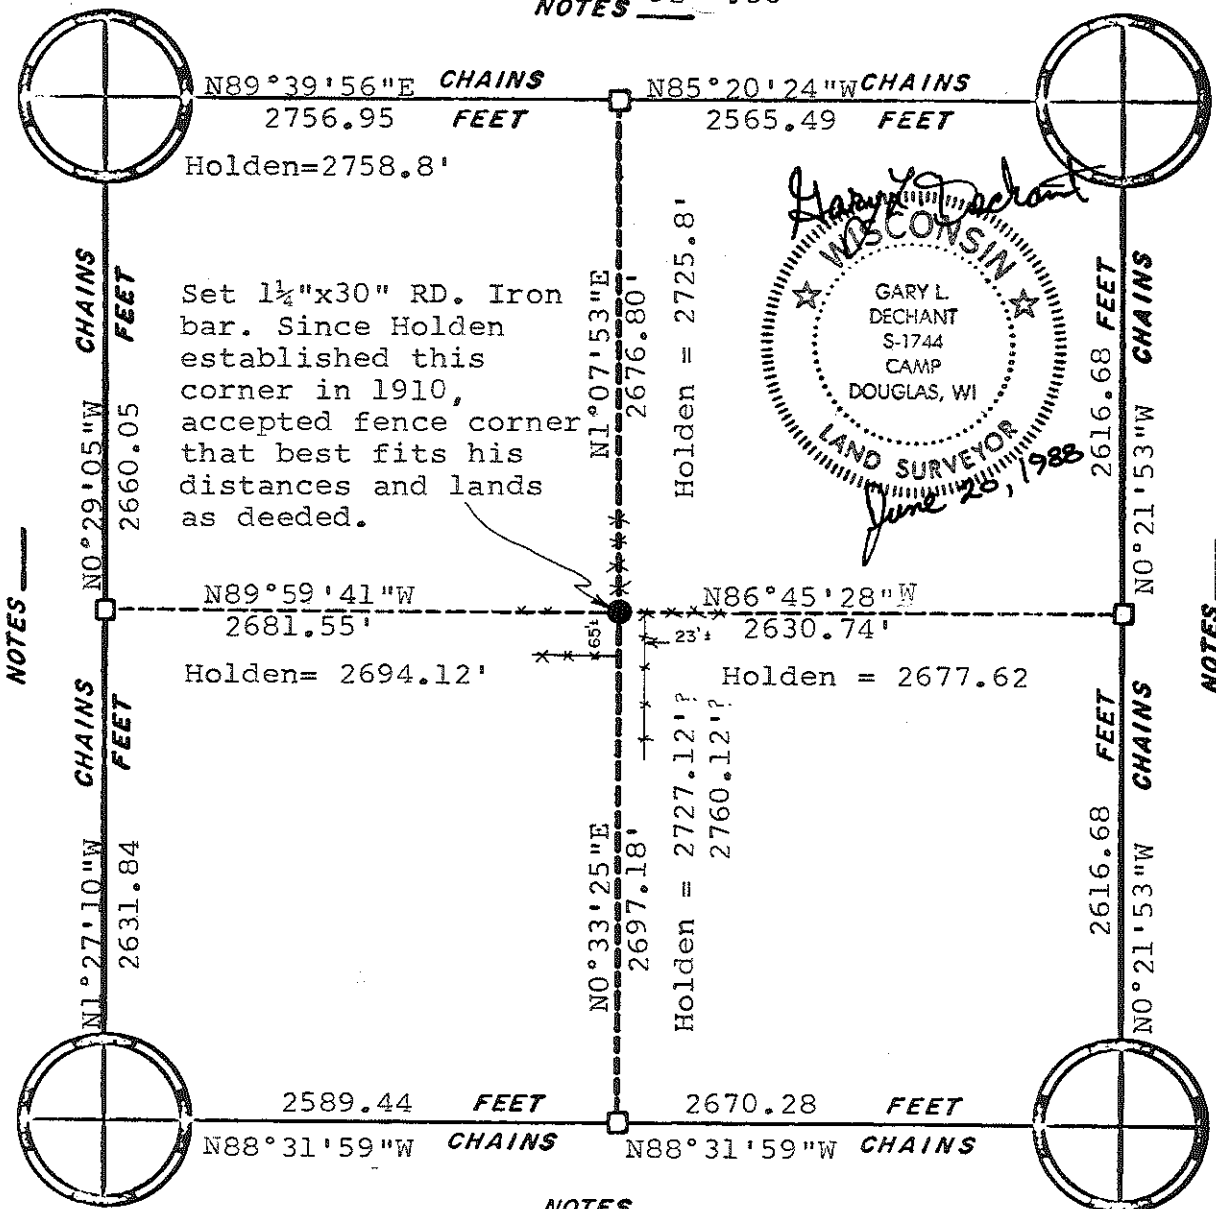

NOTES _____


ORIGINAL SURVEY DATA

BY _____


DATE _____

SURVEYED BY G.L. Dechant	CONTRACT DATE June 20, 1988	COUNTY MONROE [REDACTED]	TOWN-VILLAGE-CITY Jefferson	SECTION 8	TOWNSHIP 15N	RANGE 3W
-----------------------------	--------------------------------	-----------------------------	--------------------------------	--------------	-----------------	-------------

NOTES _____ 52.44'

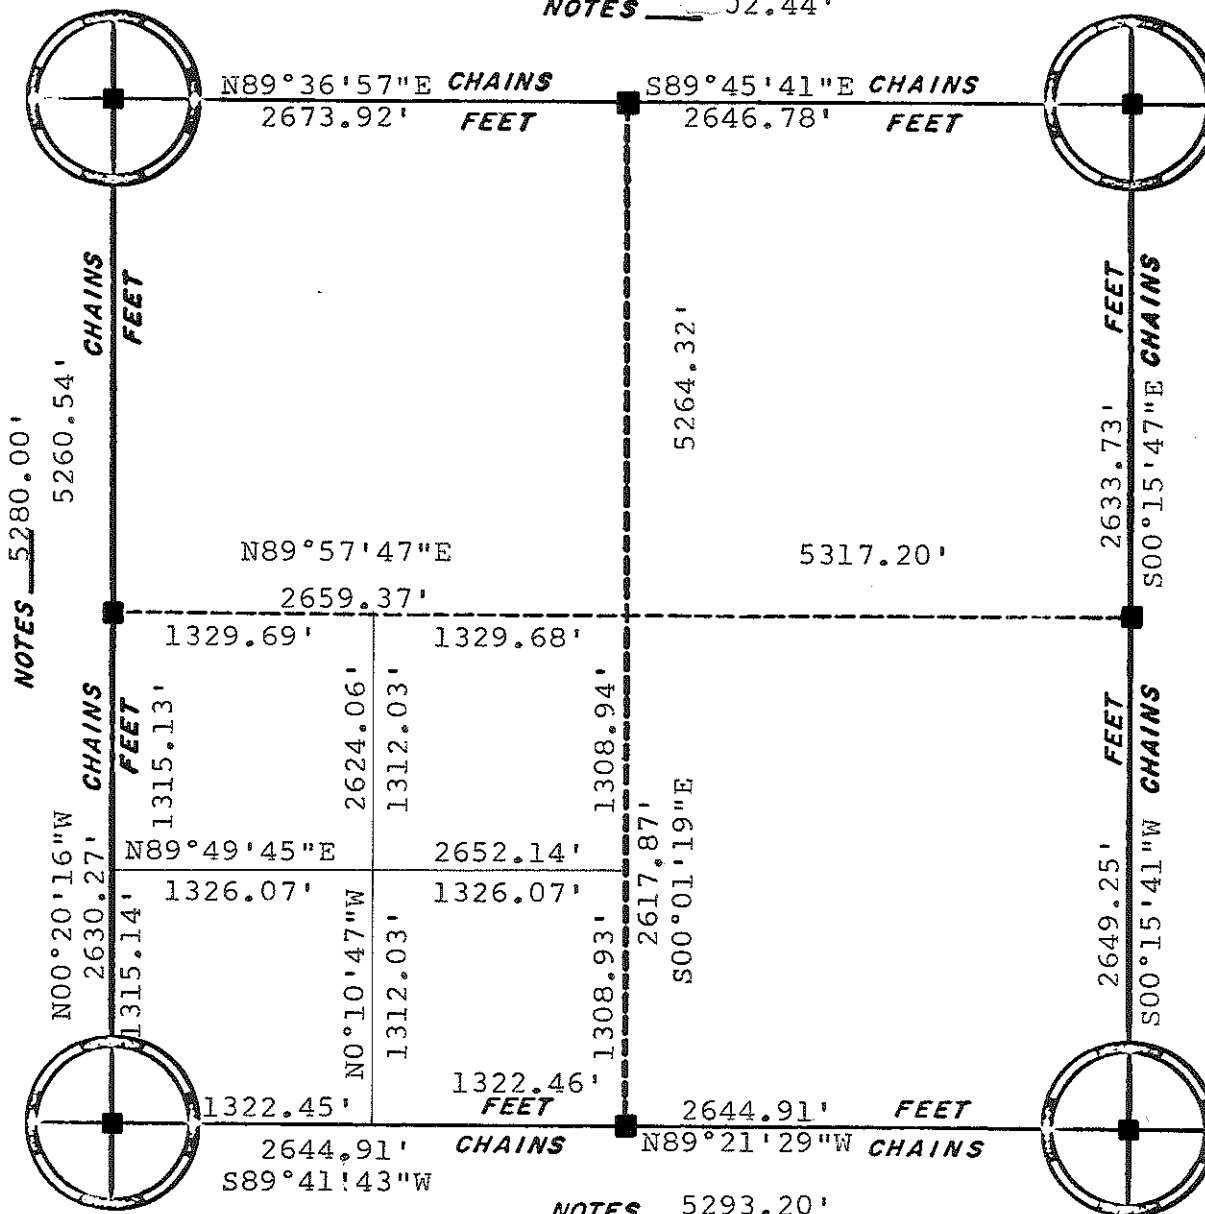

■ = set Harrison

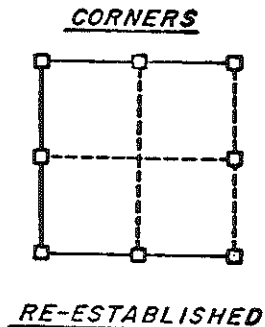

NOTES 5280.00'
SCHROEDER=5305.08'


NOTES _____ 5293.20'

ORIGINAL SURVEY DATA

BY _____
DATE _____

SURVEYED BY L.A. Feddersen D.J. Malliet	CONTRACT DATE Dec., 1977	COUNTY MONROE [REDACTED]	TOWN-VILLAGE-CITY JEFFERSON	SECTION 10	TOWNSHIP 15N	RANGE 3W
---	-----------------------------	-----------------------------	--------------------------------	---------------	-----------------	-------------


NOTES _____

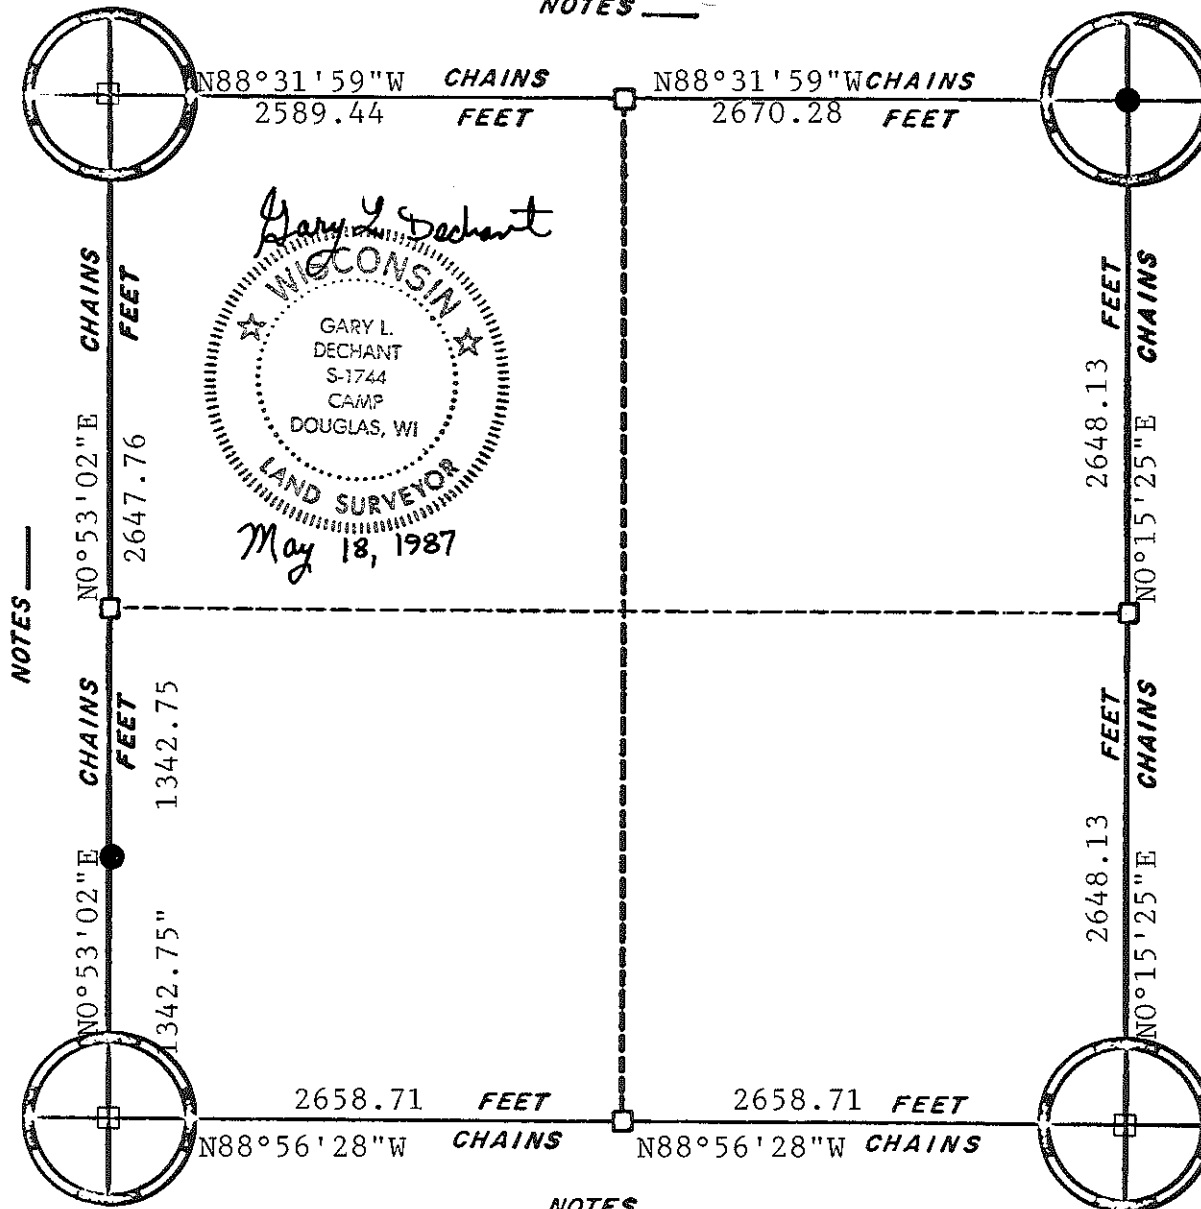

Gary L. Dechant
 WISCONSIN
 GARY L. DECHANT
 S-1744
 CAMP DOUGLAS, WI
 LAND SURVEYOR
May 18, 1987



- = Harrison Marker
- = Set 1 1/2" x 30" iron bar

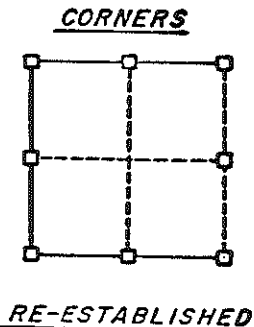


NOTES _____

NOTES _____


ORIGINAL SURVEY DATA

BY _____
 DATE _____

SURVEYED BY Gary L. Dechant	CONTRACT DATE May 18, 1987	COUNTY MONROE ██████████	TOWN-VILLAGE-CITY Jefferson	SECTION 17	TOWNSHIP 15N	RANGE 3W
--------------------------------	-------------------------------	-----------------------------	--------------------------------	---------------	-----------------	-------------

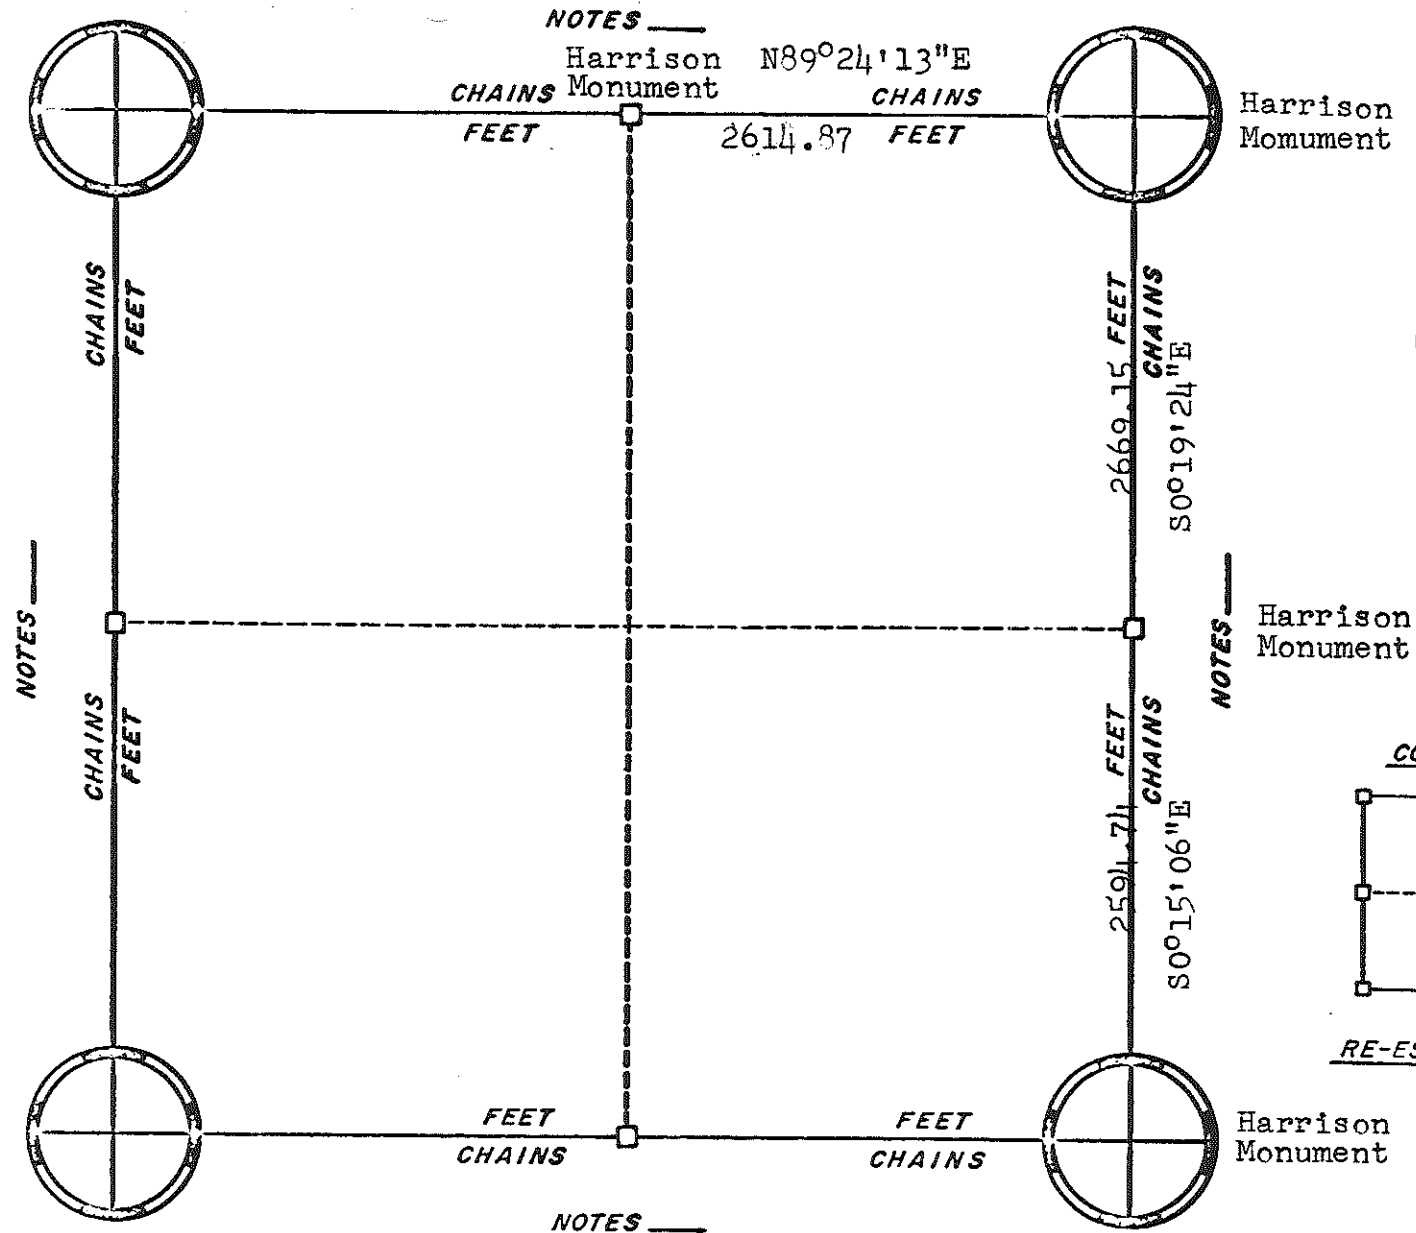

CORNERS

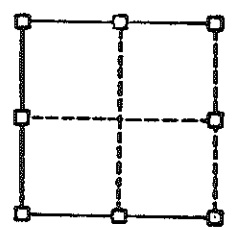


RE-ESTABLISHED

ORIGINAL SURVEY DATA

BY _____
DATE 3/16/81


SURVEYED BY	CONTRACT DATE	COUNTY MONROE	TOWN-VILLAGE-CITY	SECTION	TOWNSHIP	RANGE
W. C. Jung	September, 1979	██████████	Jefferson	23	T15N	R3W

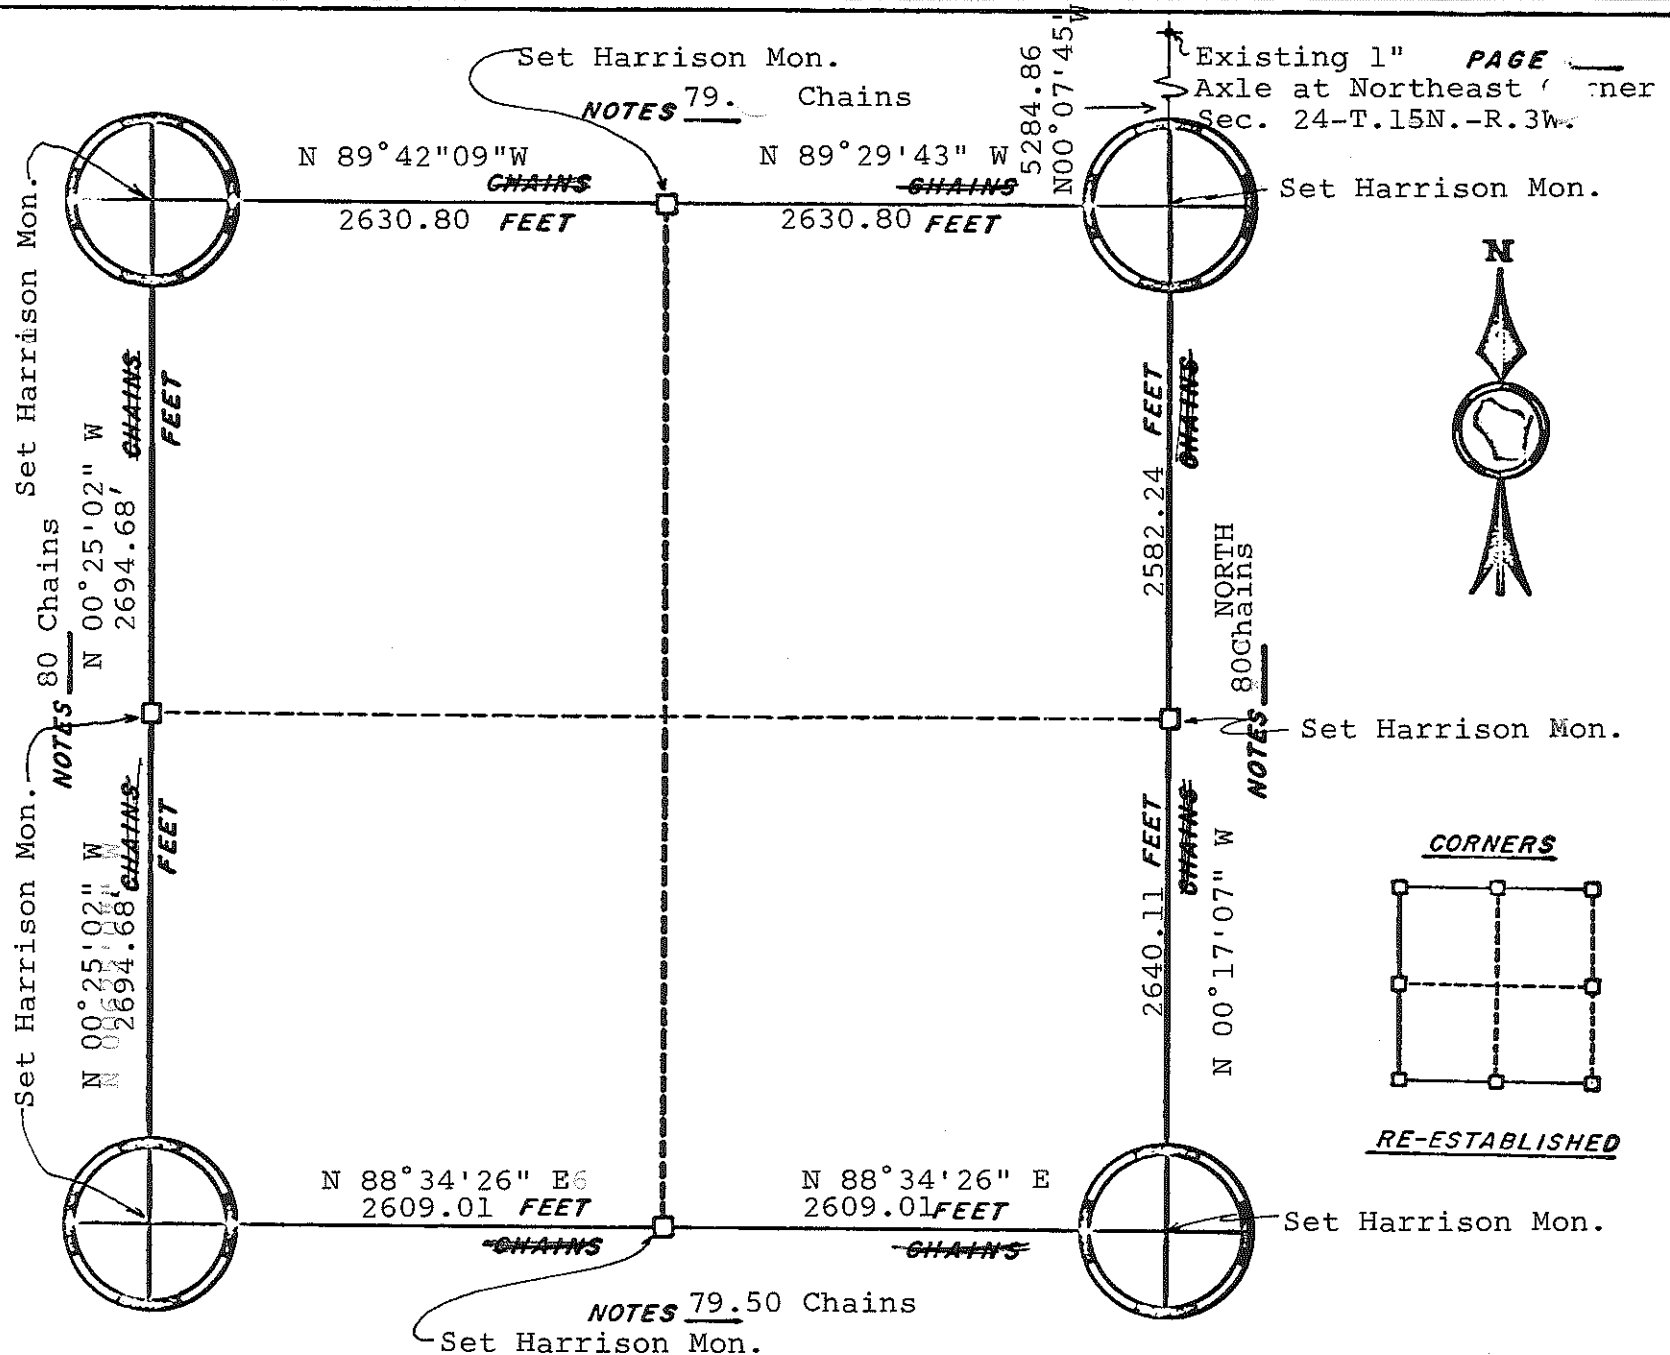

ORIGINAL SURVEY DATA

BY [REDACTED]
DATE May 23, 1979

SURVEYED BY Heidecke Feddersen	CONTRACT DATE	COUNTY MONROE	TOWN-VILLAGE-CITY Jefferson	SECTION 25	TOWNSHIP 15	RANGE 3W
--------------------------------------	---------------	---------------	--------------------------------	---------------	----------------	-------------

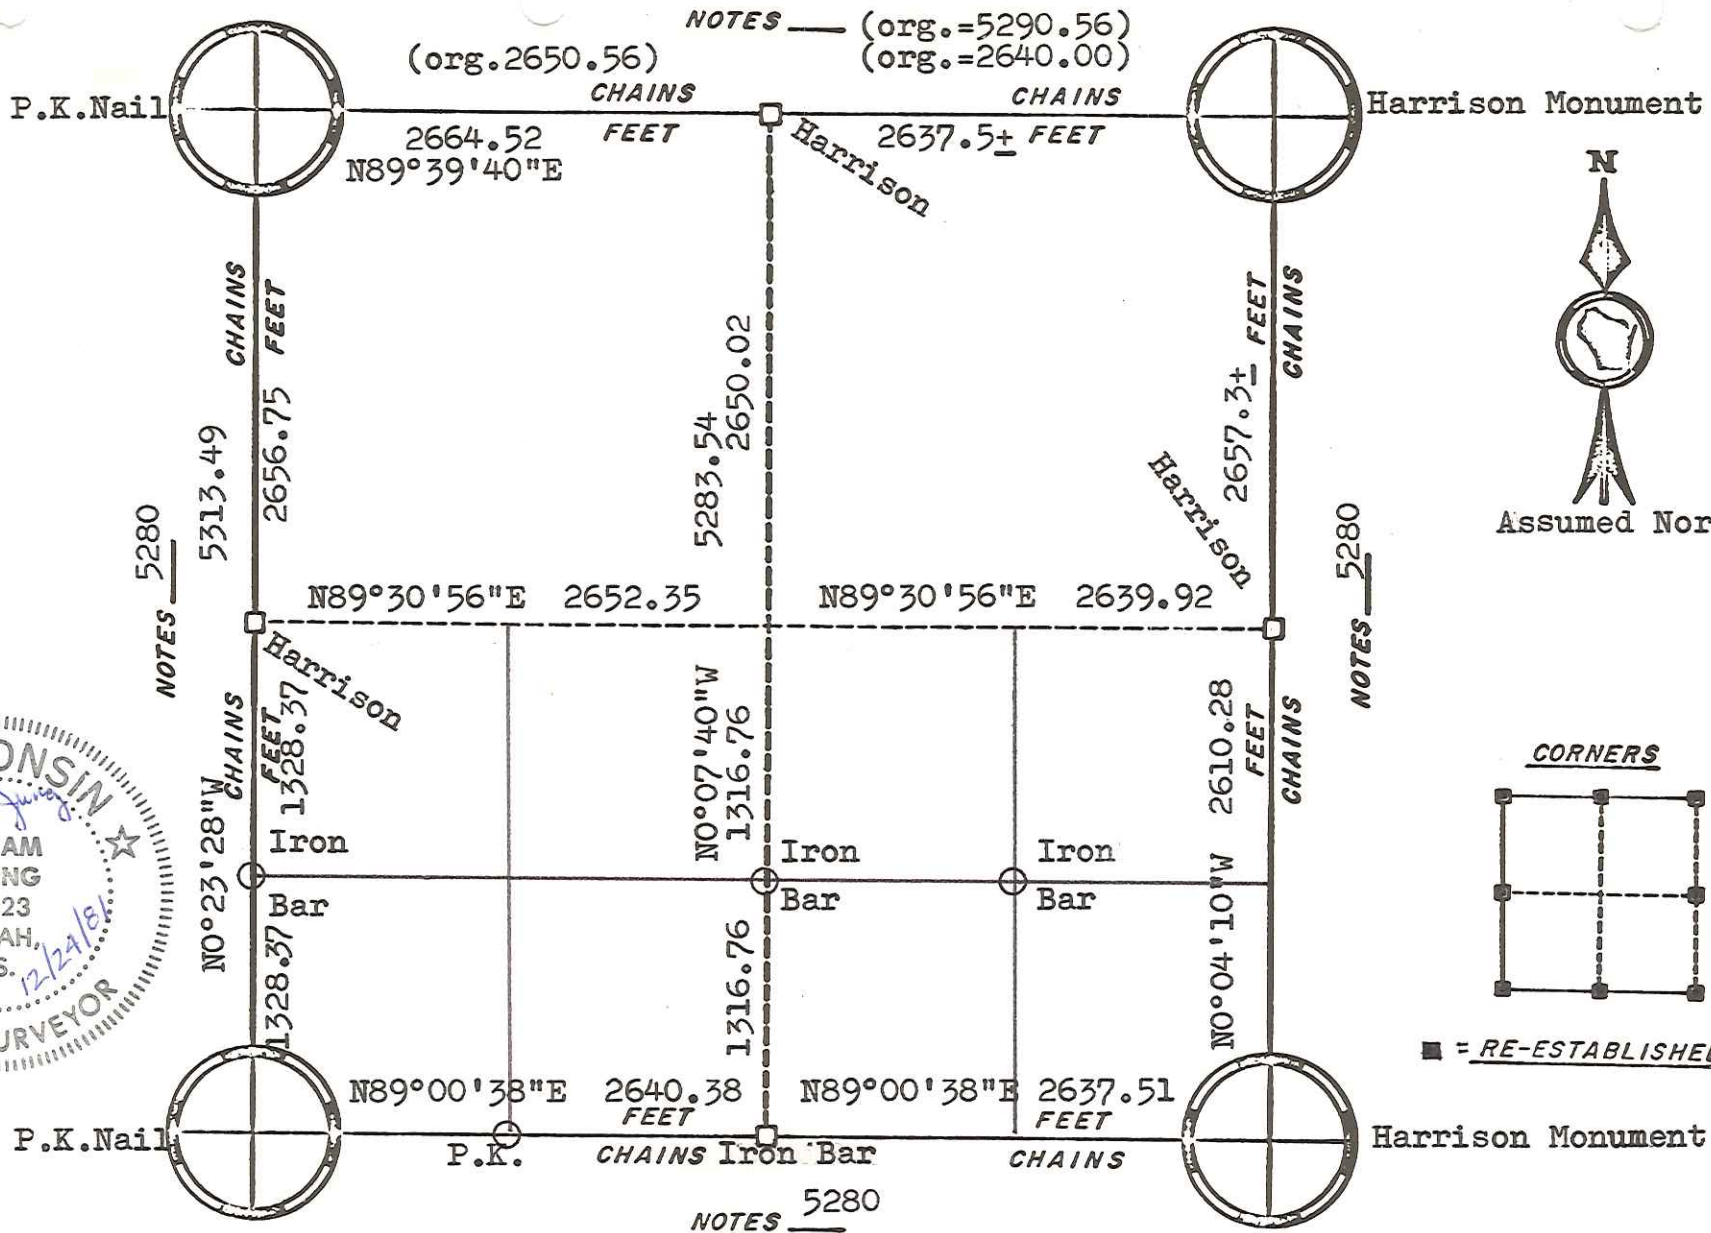

WISCONSIN
 WILLIAM C. JUNG
 1323 TOMAH, WIS.
 12/24/81
 LAND SURVEYOR

Closure:

ORIGINAL SURVEY DATA

BY _____
 DATE 12/23/81

SURVEYED BY W.C. Jung	CONTRACT DATE December, 1981	COUNTY MONROE	TOWN-VILLAGE-CITY Jefferson	SECTION 33	TOWNSHIP 15N	RANGE 3W
--------------------------	---------------------------------	------------------	--------------------------------	---------------	-----------------	-------------