

21504010000

I, Garold A. Sime, do hereby certify that on the 3rd day of August 1984, I found ~~evidence~~ (no evidence) of the SW corner of Section 6, T 15 N, R 3 W Fourth Principal Meridian, and I re-established said corner according to the Wisconsin Statutes as shown and described hereon.

Dated this 21st day of Dec. 1984.

Garold A. Sime

Garold A. Sime, R.L.S. 1261
Title

History of corner establishment since Original Government Survey

A.S. Ingalls was at this corner in May 1873
Fred Holden was at this corner in April of 1903

Description of corner evidence found:

I set this corner on line and equidistant from the W¹/₄ corner of said Sec.6 thru the northwest corner of the SW¹/₄-SW¹/₄ of Sec.6 (established from Holdens Brg. Tree) This location fits the west line of Sec. 6 extremely well.

COUNTY SURVEYOR FORM NO. 1


Description of corner and witness monuments, references and accessories used to perpetuate the original or re-established location of this corner:

Set Harrison Monument at corner


Witnesses to corner location:

G. A. Sime

Dallas Wilhite

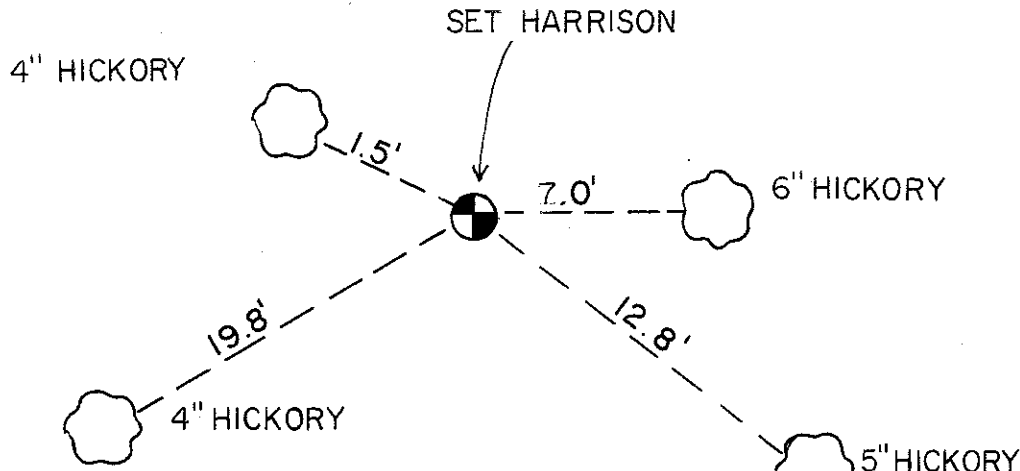

Note; All distances are slope measured. Trees are double blazed with a nail in hack in side of tree.

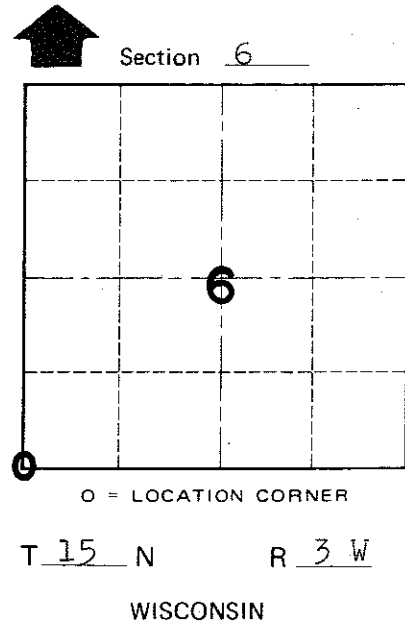

SURVEY CONTROL ORDER

Horizontal _____
Vertical _____

WISCONSIN COORDINATE SYSTEM

Corner	East (X)	North (Y)	Elevation (Z)	Zone
Control Sta. Name				

City, Village or Town Jefferson

County of Monroe