

CERTIFICATE

CERTIFIED LAND CORNER

No. 108

21504280020

I, Robert M. Lampman, do hereby certify that on the 11th day of December 1978, I found ~~(evidence)~~ (no evidence) of the N 1/4 corner of Section 33, T 15 N, R 4 W X, Fourth Principal Meridian, and I re-established said corner according to the Wisconsin Statutes as shown and described hereon.

Dated this 12th day of Jan. 1979.

Robert M. Lampman 5-1296

LAMPMAN & ASSOCIATES
Title

History of original corner establishment:

Subdivision of Town 15 North, Range 4 West. Henry Maddin, 1847. Deputy Surveyor.

Description of corner evidence found:

After having run extensive control traverse in Section 33, and made extensive search for original corner and bearing trees in areas designated by recorded distances of original and/or resurvey and having done the same in areas of occupation of said corner, I set corner on line with and at equal distances between the Northwest Corner and the Northeast Corner of said Section 33.

Description of corner and witness monuments, references and accessories used to perpetuate the original or re-established location of this corner:

Witnesses to corner location:

Ronald Hayden, Crew Chief

Gerald Torgerson

William Woodman

Poplar w/spike
N30°W, 16.00'
Diam. 12"


Maple w/spike
N60°E, 21.68'
Diam. 5"

Harrison Monument
in mound of stone

Maple w/spike
S10°E, 5.74'
Diam. 6"

Maple w/spike
S45°W, 21.77'
Diam. 7"

Steep
Slope

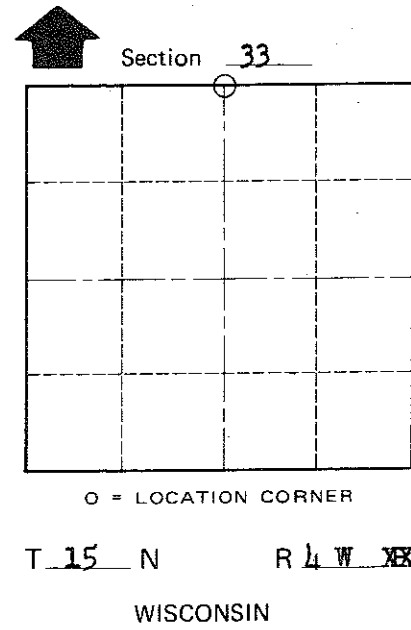

COUNTY SURVEYOR FORM NO. 1

SURVEY CONTROL ORDER

Horizontal	_____
Vertical	_____

WISCONSIN COORDINATE SYSTEM

Corner	East (X)	North (Y)	Elevation (Z)	Zone
Control Sta. Name				

City, Village or Town Portland

County of Monroe