

CERTIFICATE

CERTIFIED LAND CORNER

No. 115

21504312000

I, Douglas J. Malliet, do hereby certify that on the 11 day of May 19 78, I found (evidence) (~~XXXXXXXX~~) of the W 1/2 corner of Section 32, T 15 N, R 4 W, Fourth Principal Meridian, and I re-established said corner according to the Wisconsin Statutes as shown and described hereon.

Dated this 17 day of May 19 78.

Douglas J. Malliet

REGISTERED LAND SURVEYOR, S-1266
Title

History of original corner establishment:

No subsequent history of monument perpetuation since the original U.S. Government Survey.

Description of corner evidence found:



This corner was established at the intersection of the existing North-South fence and the extension of an existing East-West fence to the East of this location. An Adjoining landowner, Olaf Olson, believed this was very close to the former location of the corner as best as he could recollect. Considering our measurements for 1 1/2 miles North, and given the fact that we could not locate any evidence of the SW corner of Sec. 32; and also considering the extremely hilly terrain, lead to the conclusion that the evidence we had at this corner location was substantial enough to use.

Description of corner and witness monuments, references and accessories used to perpetuate the original or re-established location of this corner:

Witnesses to corner location:

Douglas J. Malliet

Lawrence A. Feddersen

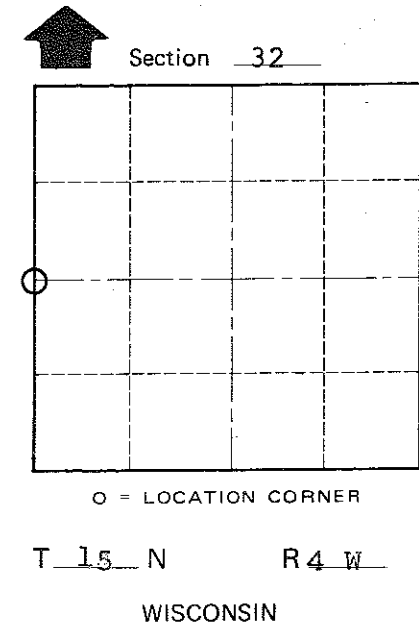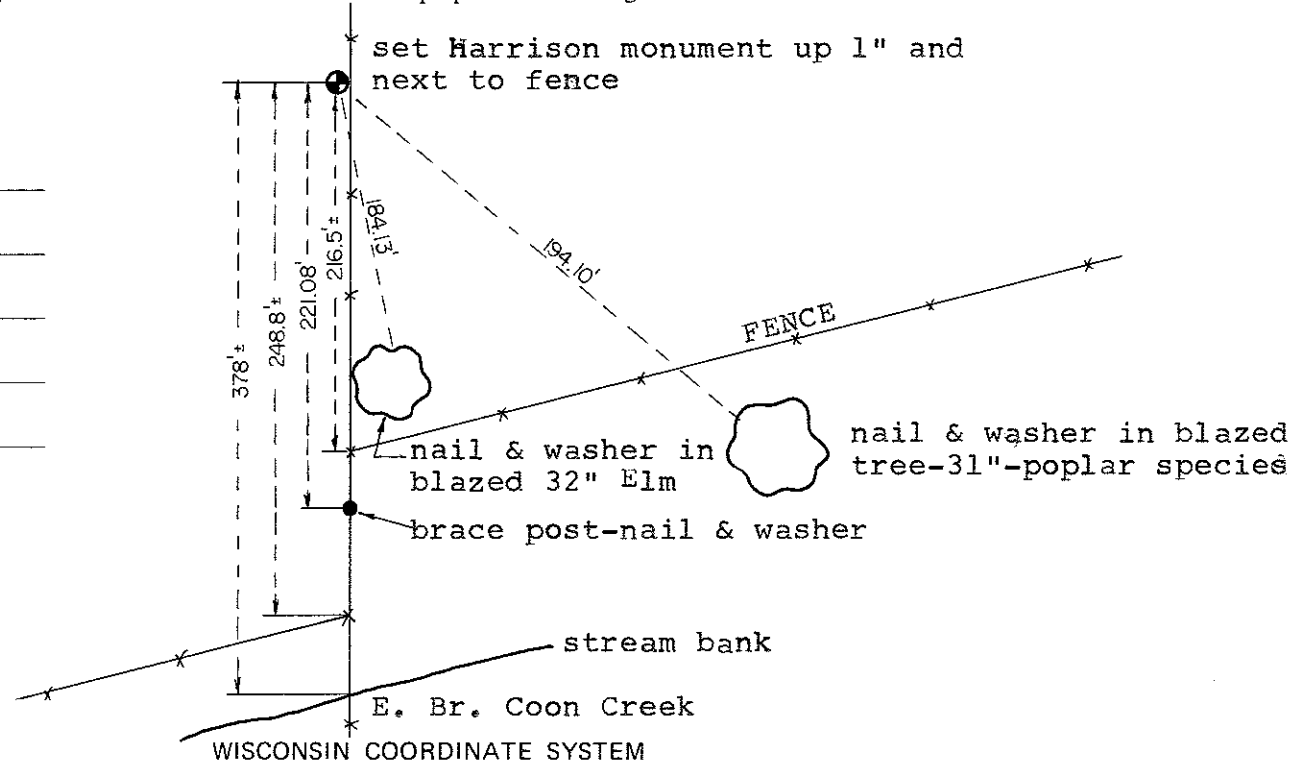

COUNTY SURVEYOR FORM NO. 1

SURVEY CONTROL ORDER

Horizontal	_____
Vertical	_____

Corner	East (X)	North (Y)	Elevation (Z)	Zone
Control Sta. Name				

City, Village or Town of PORTLAND

County of MONROE