

CERTIFICATE

CERTIFIED LAND CORNER

No. 129

21504320000

I, Robert M. Lampman, do hereby certify that on the 11th day of December 1978, I found (evidence) (~~no evidence~~) of the SW corner of Section 33, T 15 N, R 4 W E, Fourth Principal Meridian, and I re-established said corner according to the Wisconsin Statutes as shown and described hereon.

Dated this 18th day of Jan. 1979.

Robert M. Lampman 5-1296

LAMPMAN & ASSOCIATES  
Title

History of original corner establishment:

Subdivision of Town 15 North, Range 4 West, Henry Maddin, 1847, Deputy Surveyor.

Description of corner evidence found:



The Southwest Corner was relocated by the aid of a bearing tree as surveyed by Henry Maddin, 1847.  
Sugar Maple 24" Diam. N75E 41 Links

NOTE: Fits old occupation fence.

Description of corner and witness monuments, references and accessories used to perpetuate the original or re-established location of this corner:

Witnesses to corner location:

Ronald Hayden, Crew Chief  
Gerald Torgerson  
William Woodman

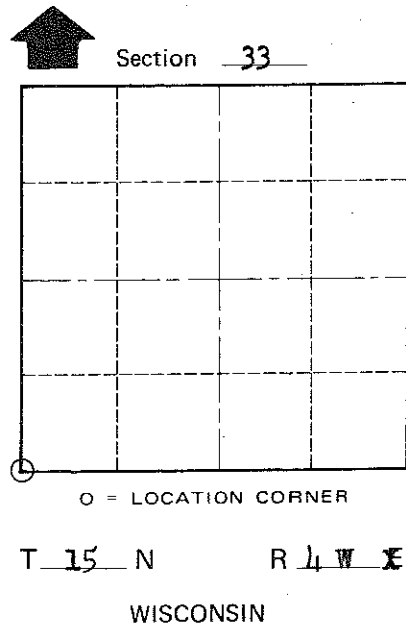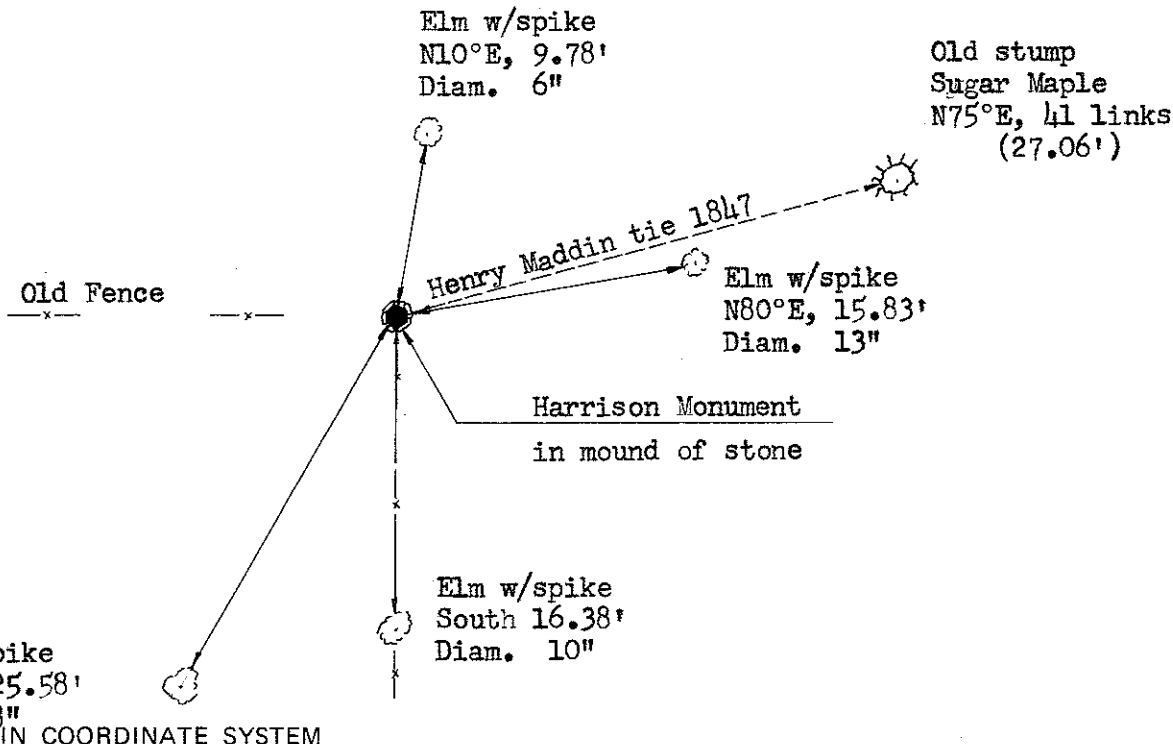

COUNTY SURVEYOR FORM NO. 1

SURVEY CONTROL ORDER

Horizontal	_____
Vertical	_____

Corner	East (X)	North (Y)	Elevation (Z)	Zone
Control Sta. Name				

City, Village or Town Portland

County of Monroe