

CERTIFICATE

CERTIFIED LAND CORNER

No. 116

21504322000

I, Robert M. Lampman, do hereby certify that on the 14th day of December 1978, I found (evidence) (~~no evidence~~) of the West 1/4 corner of Section 33, T 35 N, R 4 W E, Fourth Principal Meridian, and I re-established said corner according to the Wisconsin Statutes as shown and described hereon.

History of original corner establishment:

Subdivision of Town 15 North, Range 4 West. Henry Maddin, 1847, Deputy Surveyor.

Dated this 10th day of Jan. 1979.

Robert M. Lampman 5-1296

Description of corner evidence found:

After having run extensive control traverse within Section 33 and made extensive search for original corner and bearing trees in areas designated by recorded distances of original survey and/or resurvey and having done the same in areas of occupation of said corner, I set corner on line with and at equal distances between the Northwest Corner and the Southwest Corner of said Section 33.

LAMPMAN & ASSOCIATES
Title



NOTE: West 1/4 corner fit old occupation fence.

COUNTY SURVEYOR FORM NO. 1

Description of corner and witness monuments, references and accessories used to perpetuate the original or re-established location of this corner:

Witnesses to corner location:

Ronald Hayden, Crew Chief
Gerald Torgerson
William Woodman

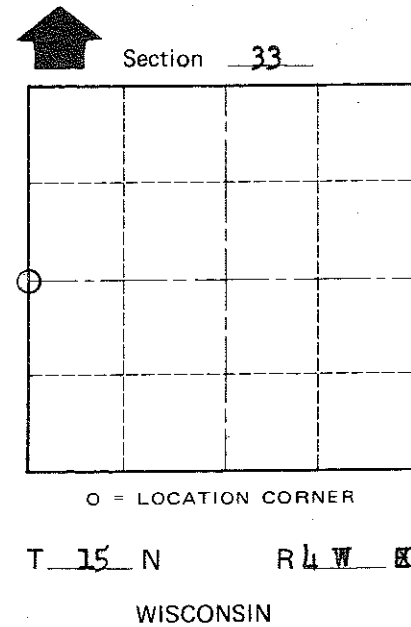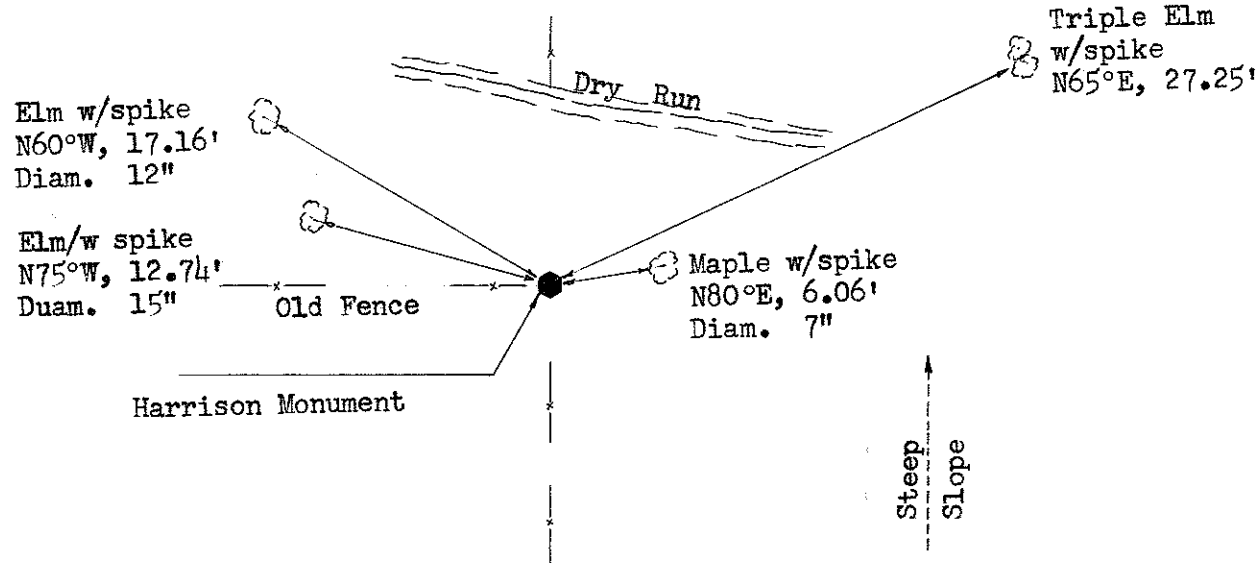

SURVEY CONTROL ORDER

Horizontal	_____
Vertical	_____

WISCONSIN COORDINATE SYSTEM

Corner	East (X)	North (Y)	Elevation (Z)	Zone
Control Sta. Name				

City, Village or Town Portland
County of Monroe