

CERTIFICATE

CERTIFIED LAND CORNER

No. 128

21504330020

I, Robert M. Lampman, do hereby certify that on the 14th day of December 19 78, I found (evidence) (~~no evidence~~) of the South 1/4 corner of Section 33, T 15 N, R 4 W, Fourth Principal Meridian, and I re-established said corner according to the Wisconsin Statutes as shown and described hereon.

Dated this 12th day of Jan. 19 79.

Robert M. Lampman 5-1296

LAMPMAN & ASSOCIATES
Title

History of original corner establishment:

Subdivision of Town 15 North, Range 4 West. Henry Maddin, 1847, Deputy Surveyor.

Description of corner evidence found:

After having run extensive control traverse in Section 33 and made extensive search for corner and bearing trees in areas designated by recorded distances of original survey and/or resurvey and having done the same in areas of occupation of said corner, I accepted evidence of occupation to set corner.

COUNTY SURVEYOR FORM NO. 1



Description of corner and witness monuments, references and accessories used to perpetuate the original or re-established location of this corner:

Witnesses to corner location:

Ronald Hayden, Crew Chief

Gerald Torgerson

William Woodman

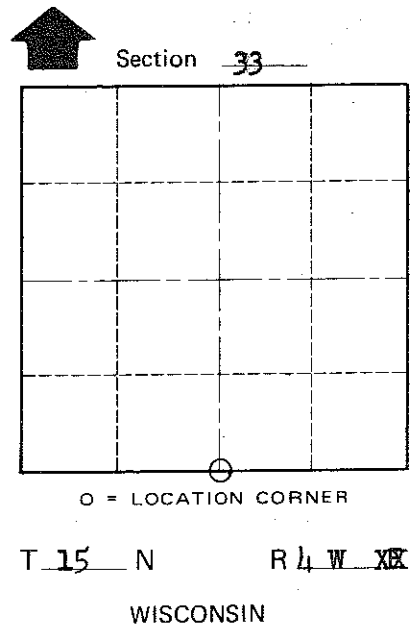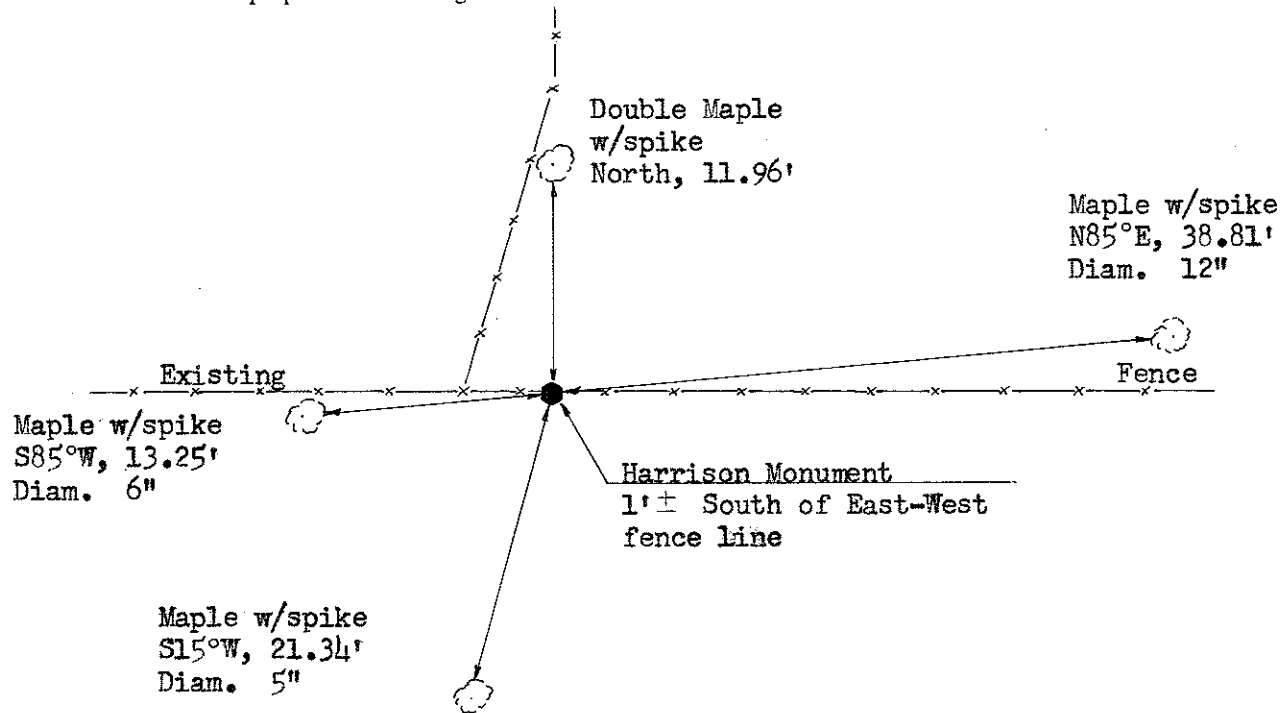

SURVEY CONTROL ORDER

Horizontal	_____
Vertical	_____

WISCONSIN COORDINATE SYSTEM

Corner	East (X)	North (Y)	Elevation (Z)	Zone
Control Sta. Name				

City, Village or Town Portland

County of Monroe