

21504350000

I, Gary L. Dechant, do hereby certify that on the 17th day of July 1998, I found (evidence) (~~no evidence~~) of the SW corner of Section 36, T 15 N, R 4 W Fourth Principal Meridian, and I re-established said corner according to the Wisconsin Statutes as shown and described hereon.

Dated this 4th day of August 1998.

Gary L. Dechant  
Registered Land Surveyor 1744  
Title

History of corner establishment since Original Government Survey

A Vernon County Survey in Vol.1, Page 60, No. 76 shows measurements to the NE corner of Sec. 2, T14N-R4W G.S.

Description of corner evidence found:

Set on line with north-south fence and on a projected line between the occupied SE corner of the SW $\frac{1}{4}$ -SW $\frac{1}{4}$  and the S $\frac{1}{4}$  corner of Sec. 36.

Description of corner and witness monuments, references and accessories used to perpetuate the original or re-established location of this corner:

Witnesses to corner location:



David E. Madison

Gary L. Dechant

Set 2"x3' iron pipe

Set Cast Iron TCP marker at SW corner of Sec. 36 in occupied fence line Survey sign 1' north.

Set 16d nail on each side of power pole, flush

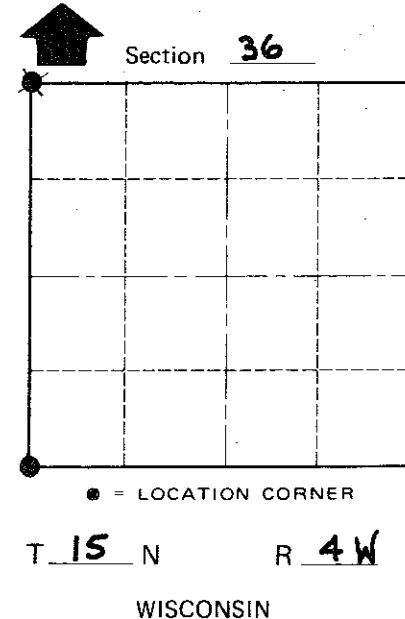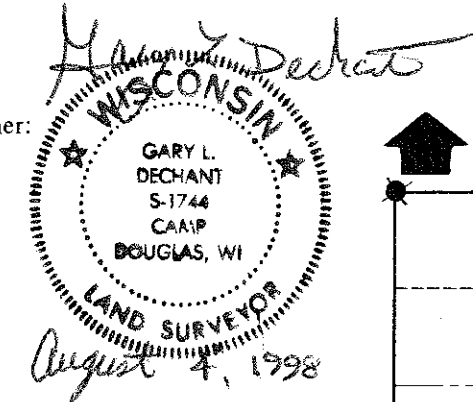

COUNTY SURVEYOR FORM NO. 1

SURVEY CONTROL ORDER

Horizontal	_____
Vertical	_____

WISCONSIN COORDINATE SYSTEM

Corner	East (X)	North (Y)	Elevation (Z)	Zone
Control Sta. Name				

City, Village or Town PORTLAND  
County of MONROE