

# 50

**U.S. PUBLIC LAND CORNER  
MAINTENANCE**

**Corner ID : N1/4 Sec.17, T16N-R1E**

**41601080020**

<u>DATE</u>	<u>CREW</u>	<u>MONUMENT TYPE -----</u>
March 6, 2019	Zachariah P.Dechant Gary L. Dechant	Existing Harrison top broke off, 18' north of road, in ditch, down 6", 15' SE of power line.

References:

	<u>Bearing</u>	<u>Distance</u>
1) Set 24" section of steel fence post (T-post),	N72E	38.63'
2) Set 24" section of steel fence post, south of road in pasture	S10E	82.34'
3) Set 24" section of steel fence post south of road in pasture	S12W	64.60'
4) Set 24" section of steel fence post	N36W	69.22'

**Note: Bearings magnetic. Compass seemed to be erratic at this area.  
Saw young Amish man on skis pulled by horse!**



I, Harley A. Sime, do hereby certify that on the 26th day of March 1980, I found ~~(evidence)~~ (no evidence) of the N. 1/4 corner of Sec. 17, T16 N, R 1 E, Fourth Principal Meridian, and I re-established said corner according to the Wisconsin Statutes as shown and described hereon.

Dated this 7th day of April 1980.

Harley A. Sime R.L.S. 355

County Surveyor

History of original corner establishment:

No known history since the original government survey.

Description of corner evidence found:

Set on line and equidistant between section corners.

**See Reverse Side For Maintenance**



Description of corner and witness monuments, references and accessories used to perpetuate the original or re-established location of this corner:

Witnesses to corner location:

G. Dechant

C. Dade

T. Tormoen

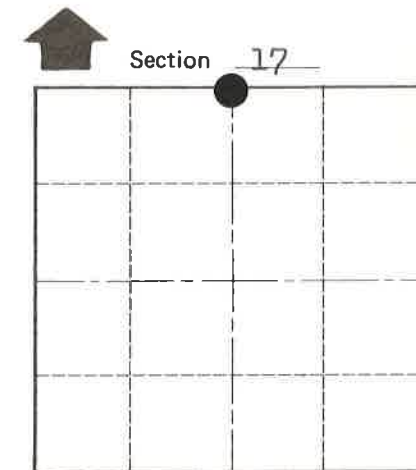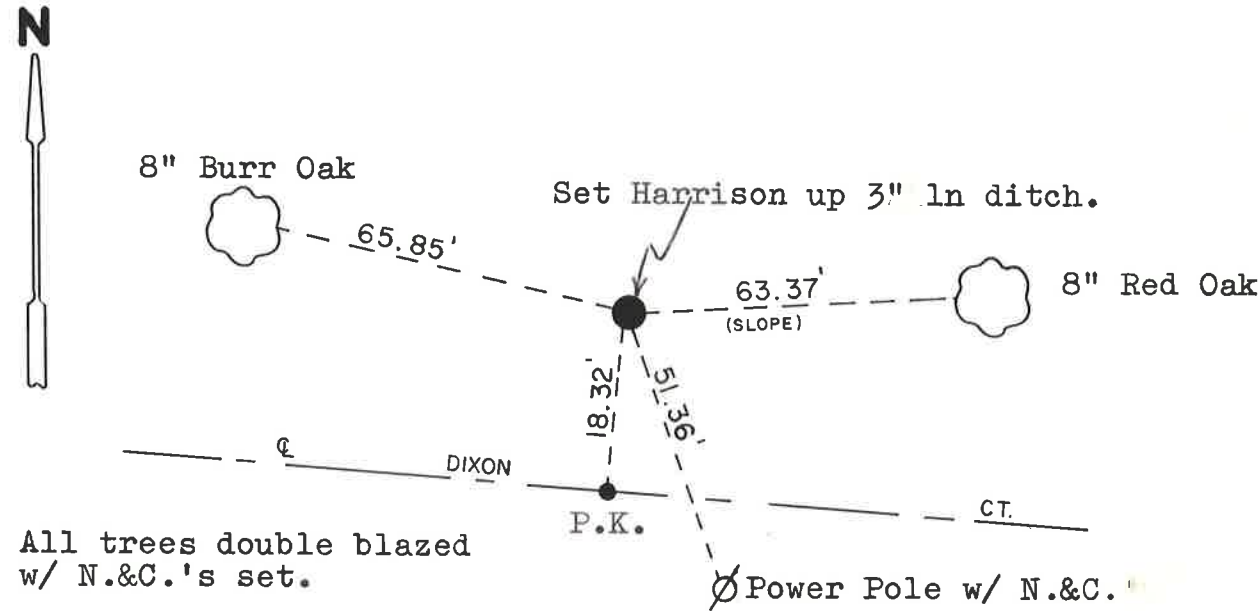

● = LOCATION CORNER

T 16 N R 1 E  
WISCONSIN

**Approved: HARLEY A. SIME**  
**MONROE CO. SURVEYOR**

SURVEY CONTROL ORDER

Horizontal	_____
Vertical	_____

WISCONSIN COORDINATE SYSTEM

Corner	East (X)	North (Y)	Elevation (Z)	Zone
Control Sta. Name				

City, Village or Town Clifton

County of Monroe

COUNTY SURVEYOR FORM NO. 1