CERTIFICATE

I, Laurence E Johns III, do hereby certify that on the 4th day of October, 2008. I found evidence of the S 1/4 corner of Section 9, T16N, R1E, Fourth Principle Meridian, and I re-established said corner according to the Wisconsin Statutes as shown and described hereon.

Dated this 5th day of October, 2008,

Control Sta. Name

12-161E

COUNTY SURVEYOR FORM NO.

Laurence E Johns III Lagle Ridge Surveying RLS 2804 PO Box 213 Wilton, WI 54670

CERTIFIED LAND CORNER

#416010900ZD

History of corner establishment since Original Government Survey

Gary Sime set a Harrison Monument at this corner in Jan 1980.

Jim Carroll was here in Apr 1989 and found no monument.

Patrick Carroll was here in Sep 2004 and used the information from the Section Summary in determining the location of the corner.

Gary Dechant was here in Dec 2006. He computed a location based off of other survey information and set the '40' Corner west of this location.

Dwayne Hefner was here in May 2008 and also used the information on the Section Summary in determining the location of the corner.

Description of corner evidence found:

Gary Sime's tie sheet calls for the location to be on the east side of a driveway. That driveway is now a town road. It is my belief that the Harrison monument was destroyed during the construction of the town road. Only one tie is remaining from the original tie sheet. Used Gary Dechant's '40' Corner and the SW Corner of Section 9 to re-establish this corner. It fit very well with the existing

No. 48 JOHNS III S-2804 Section 9

	nd witness monument ocation of this corner		essories used to perpetud	Ţ		
Witness to corner location:				Set 3	/4" IR	
Laurence E Johns III	***************************************		Set 3/4"	IR 1 & 1 / *		
Larry Handschy		Overhead Pa	N 47*41'28" W 64.35'	ville Road	10'32'39" E 88.97'	
Harrison Mon	7'31'01" W / /	SW Corner SE-SW 1" iron Pipe —————————————————————————————————	S 87'31'01" W 1365.97' S 29'38'30" W 54.91'	- \\\\\\\\\\\\\\\\\\\\\\\\\\\\\\\\\\\\	67°54'11" E 30.14' Set 3/4" IR	● = LOCATION CORNER TI6N R1E WISCONSIN
SURVEY CONTROL ORDER			Set 3/4" IR		_	
Horizontal		# NAD 83(Existing Sign	S 1/4 Corner Set 1 1/4" II	ron Rod	
			COORDINATE SYSTEM		-	OU.
4/601090020	North (Y)	East (X)	Elevation (Z)	Zone	City, Village or Town	Clifton
Corner	353854.142	739480.607			County of	Monroe

755160.517

356164.059

DRIVEWAY

Power Pole

w/N&C

Garold A. Sime	do hereby	History of corner establishment since Original Government Survey
ertify that on the	5th day	


No known history since the original government survey.

Description of corner evidence found:

Set Harrison Monument off of survey points and computations done by G. Sime in February of 1977.


ce of January _____19_80_, I found (evidence) (no evidence) of the corner of Section 16 _ . T_16_N. R 1 E Fourth Principal Meridian, and I reestablished said corner according to the Wisconsin Statutes as shown and described hereon. Dated this 28th day of Jan. 1980. Garold A. Sime, R.L.S. 1261 County Surveyor's Office

FORM NO.	Description of corner and witness monuments, re Set Harrison Monument flush, on East side of Harrison.	
OR	Witnesses to corner location:	
VEY	G. Dechant	
SUR	B. Meyer	
UNTY	T. Tormoen	_
0		

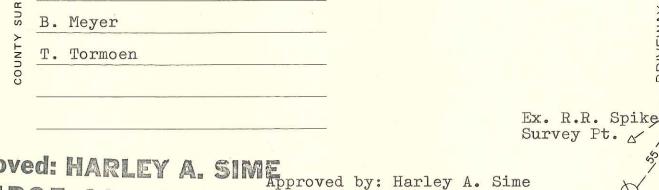



Vertical		*		
		WISCONSIN COORDINATE SYSTEM		
Corner	East (X)	North (Y)	Elevation (Z)	Zone
Control Sta. Name				

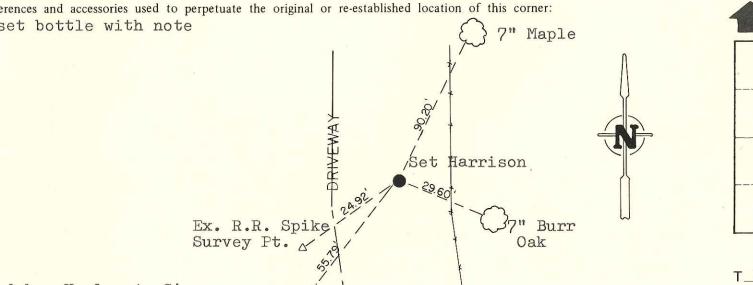

16 Section = LOCATION CORNER

T 16 N

R 1 E

WISCONSIN

(All trees double blazed with N&C's set)

Clifton City, Village or Town

Monroe County of_