

CERTIFICATE

CERTIFIED LAND CORNER

No. 56 A

41601162030

I, Harley A. Sime, do hereby certify that on the 27th day of February 19 80, I found ~~(evidence)~~ (no evidence) of the CW1/16 corner of Sec. 16, T 16 N, R 1 E Fourth Principal Meridian, and I re-established said corner according to the Wisconsin Statutes as shown and described hereon.

History of corner establishment since Original Government Survey
No known history since the original government surey.

Dated this 17th day of March 1980.

Description of corner evidence found:

Set on line and equidistant between the computed C¹/₄ corner and the monumented W¹/₄ corner of Section 16.

Harley A. Sime R.L.S. 335
County Surveyor
Title



COUNTY SURVEYOR FORM NO. 1

Description of corner and witness monuments, references and accessories used to perpetuate the original or re-established location of this corner:

Witnesses to corner location:

Dechant
Tormoen

**Approved: HARLEY A. SIME
MONROE CO. SURVEYOR**

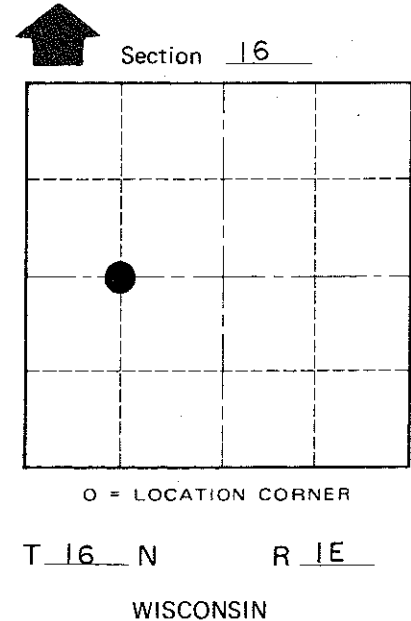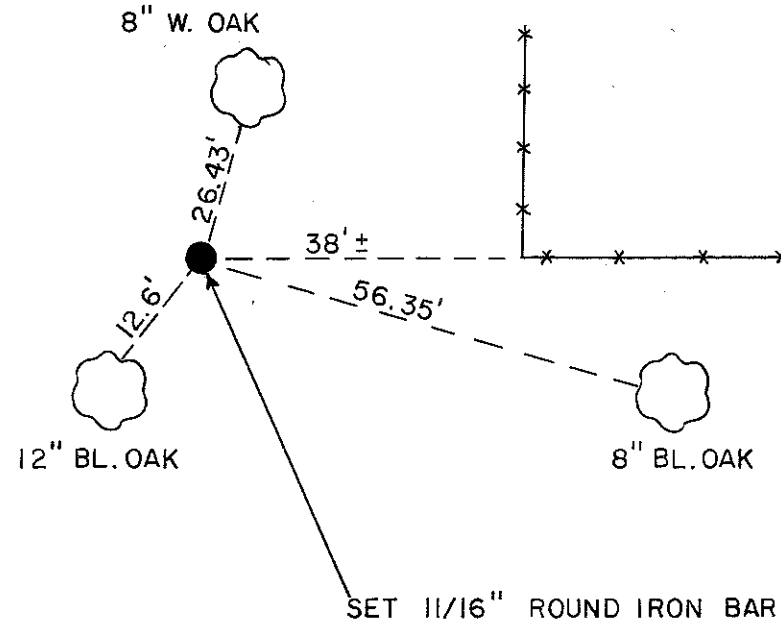

ALL TREES DOUBLE BLAZED
WITH N & Cs SET

SURVEY CONTROL ORDER

Horizontal	_____
Vertical	_____

WISCONSIN COORDINATE SYSTEM

Corner	East (X)	North (Y)	Elevation (Z)	Zone
Control Sta. Name				

City, Village or Town Clifton
County of Monroe