


The South line of Section 4 is recorded as bearing N 87°-30'-37" E

**CORNERS**

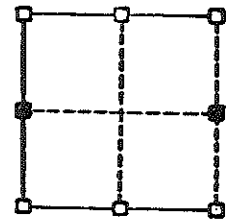

**RE-ESTABLISHED**


Nothing set as per Harley Sime 1980 survey

**ORIGINAL SURVEY DATA**


BY [Redacted]  
DATE 5/25/84

SURVEYED BY Ronald D. Parish	CONTRACT DATE	COUNTY MONROE	TOWN-VILLAGE-CITY Clifton	SECTION 4	TOWNSHIP T. 16 N.	RANGE R. 1 E.
---------------------------------	---------------	---------------	------------------------------	--------------	----------------------	------------------

NOTES \_\_\_\_\_

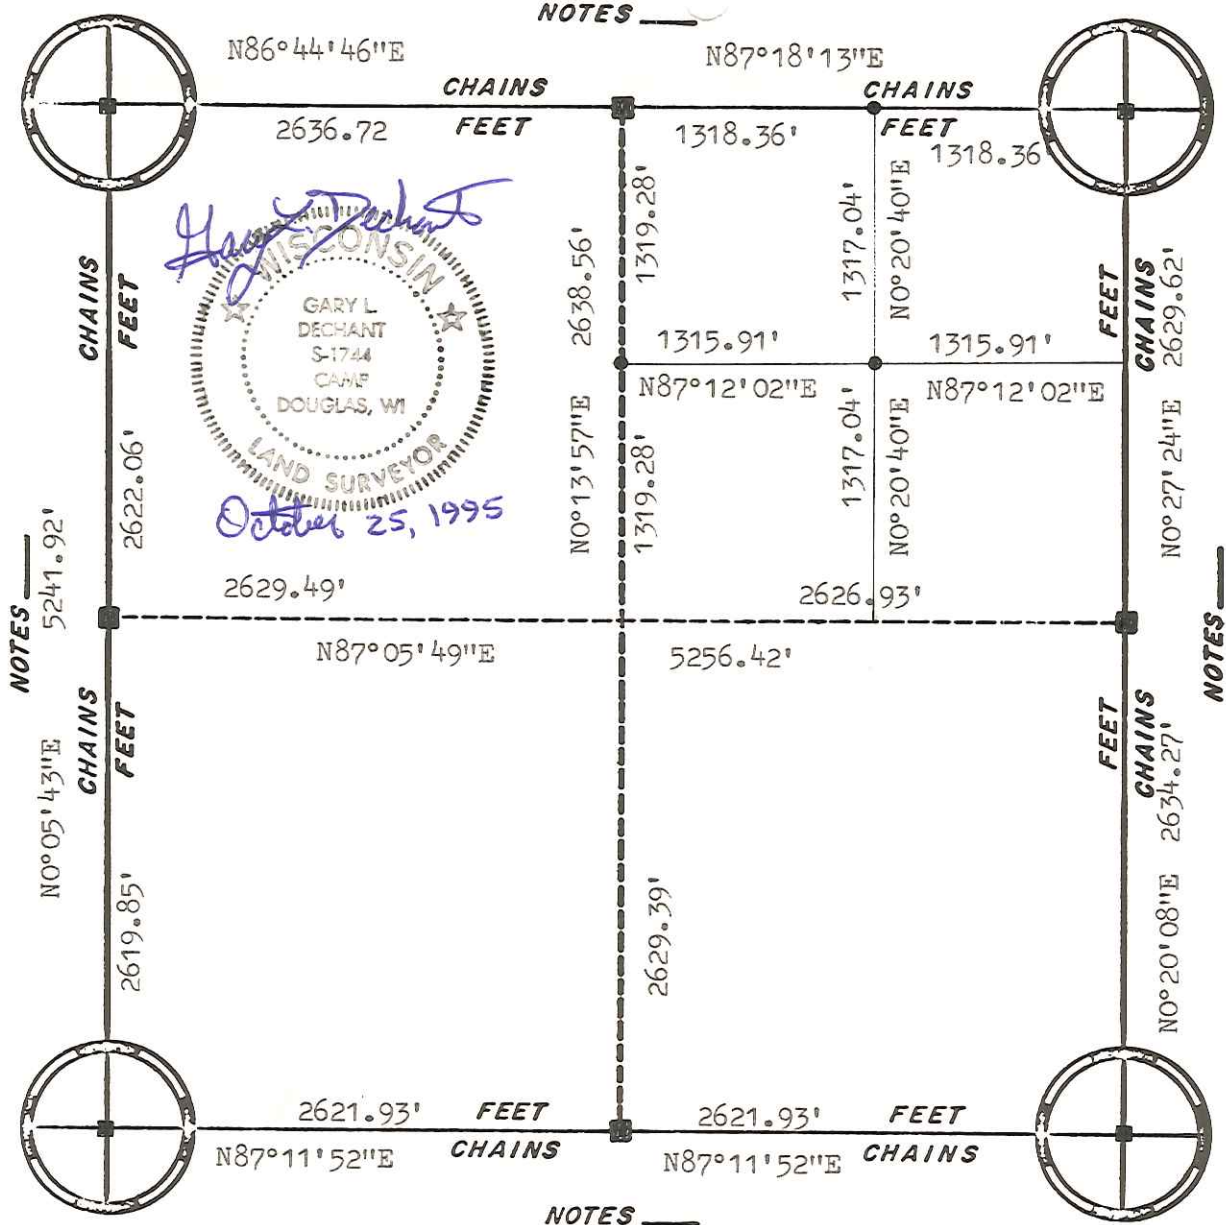

*Gary L. Dechant*  
 WISCONSIN  
 GARY L. DECHANT  
 S-1744  
 CAMP DOUGLAS, WI  
 LAND SURVEYOR  
*October 25, 1995*

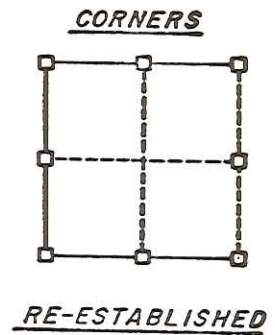

NOTES \_\_\_\_\_



NOTES \_\_\_\_\_

**ORIGINAL SURVEY DATA**

BY \_\_\_\_\_  
 DATE \_\_\_\_\_

SURVEYED BY G.L. Dechant	CONTRACT DATE October 25, 1995	COUNTY MONROE	TOWN-VILLAGE-CITY CLIFTON	SECTION 8	TOWNSHIP 16N	RANGE 1E
-----------------------------	-----------------------------------	------------------	------------------------------	--------------	-----------------	-------------

NOTES \_\_\_\_\_

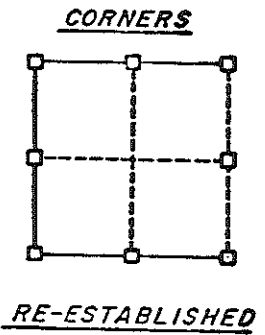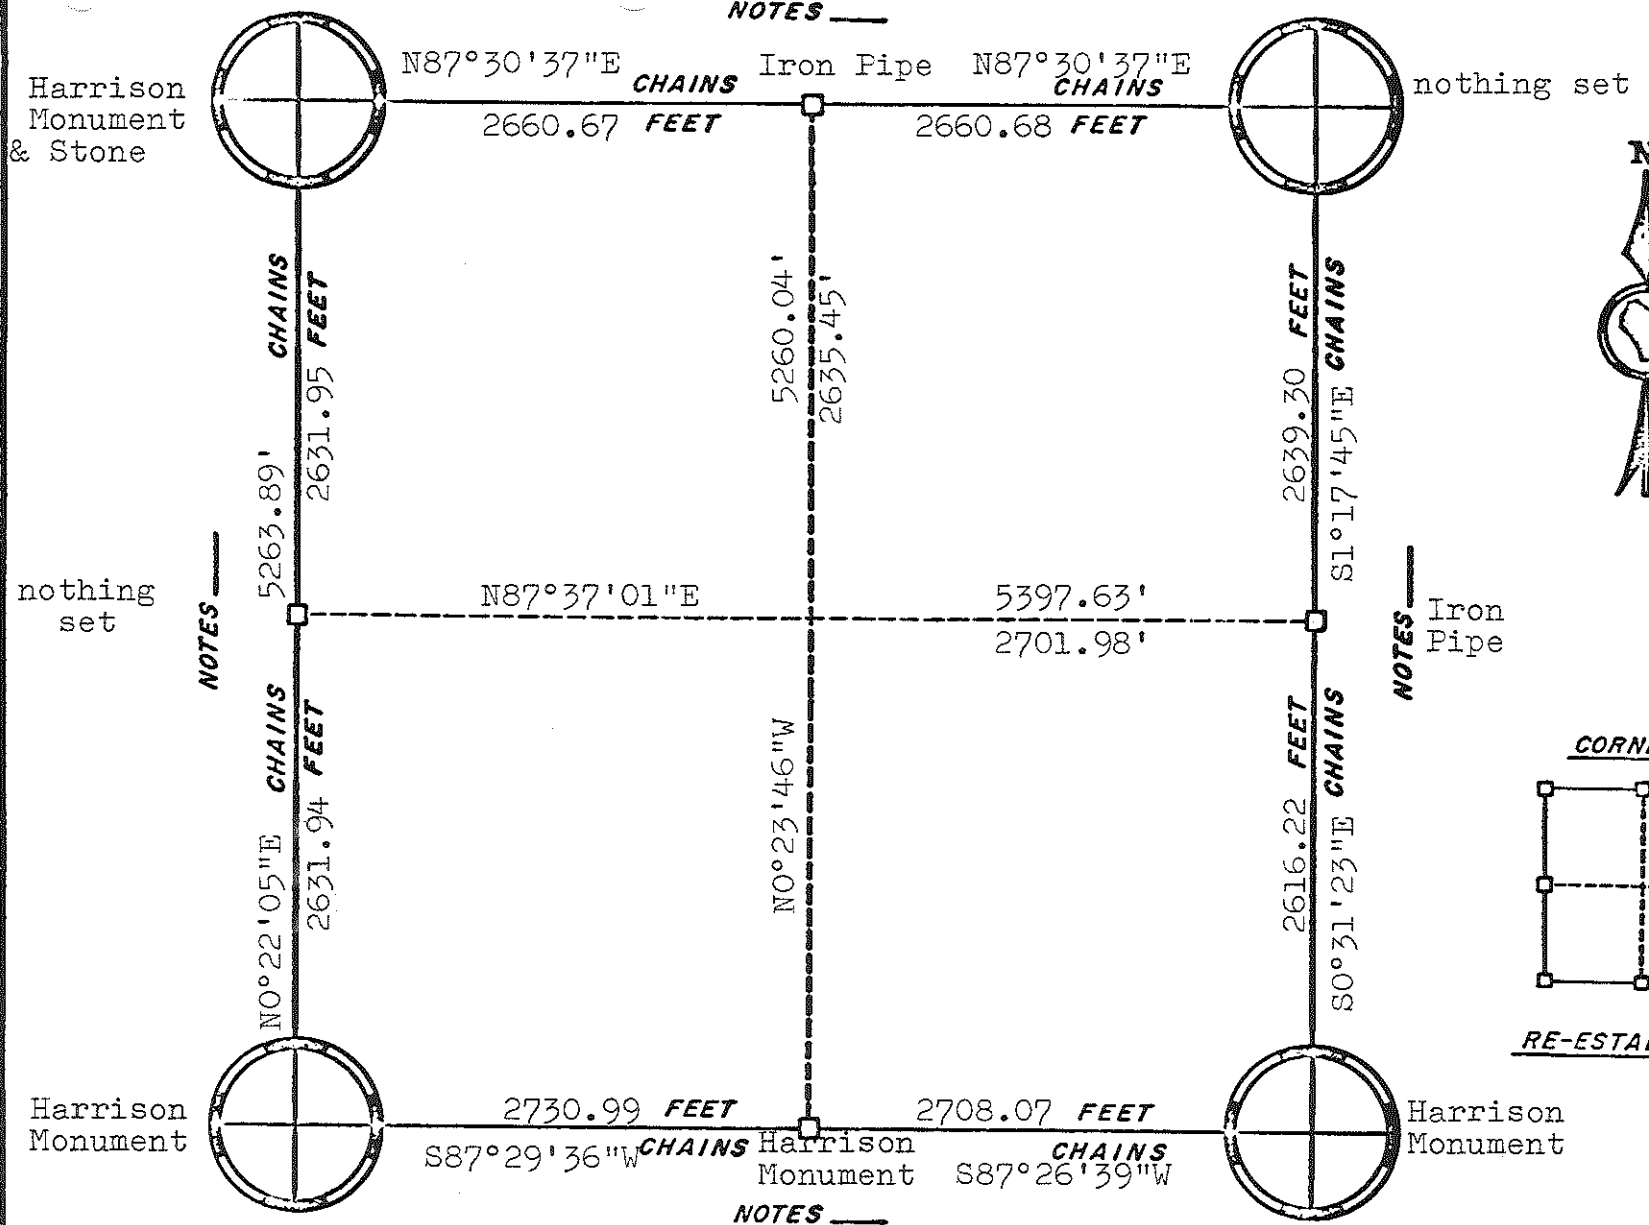


**ORIGINAL SURVEY DATA**

BY \_\_\_\_\_  
DATE 3/17/81

SURVEYED BY H. A. SIME	CONTRACT DATE October, 1980	COUNTY MONROE	TOWN- <del>CLAY</del> CITY Clifton	SECTION 9	TOWNSHIP T16N	RANGE R1E
---------------------------	--------------------------------	------------------	---------------------------------------	--------------	------------------	--------------



NOTES \_\_\_\_\_

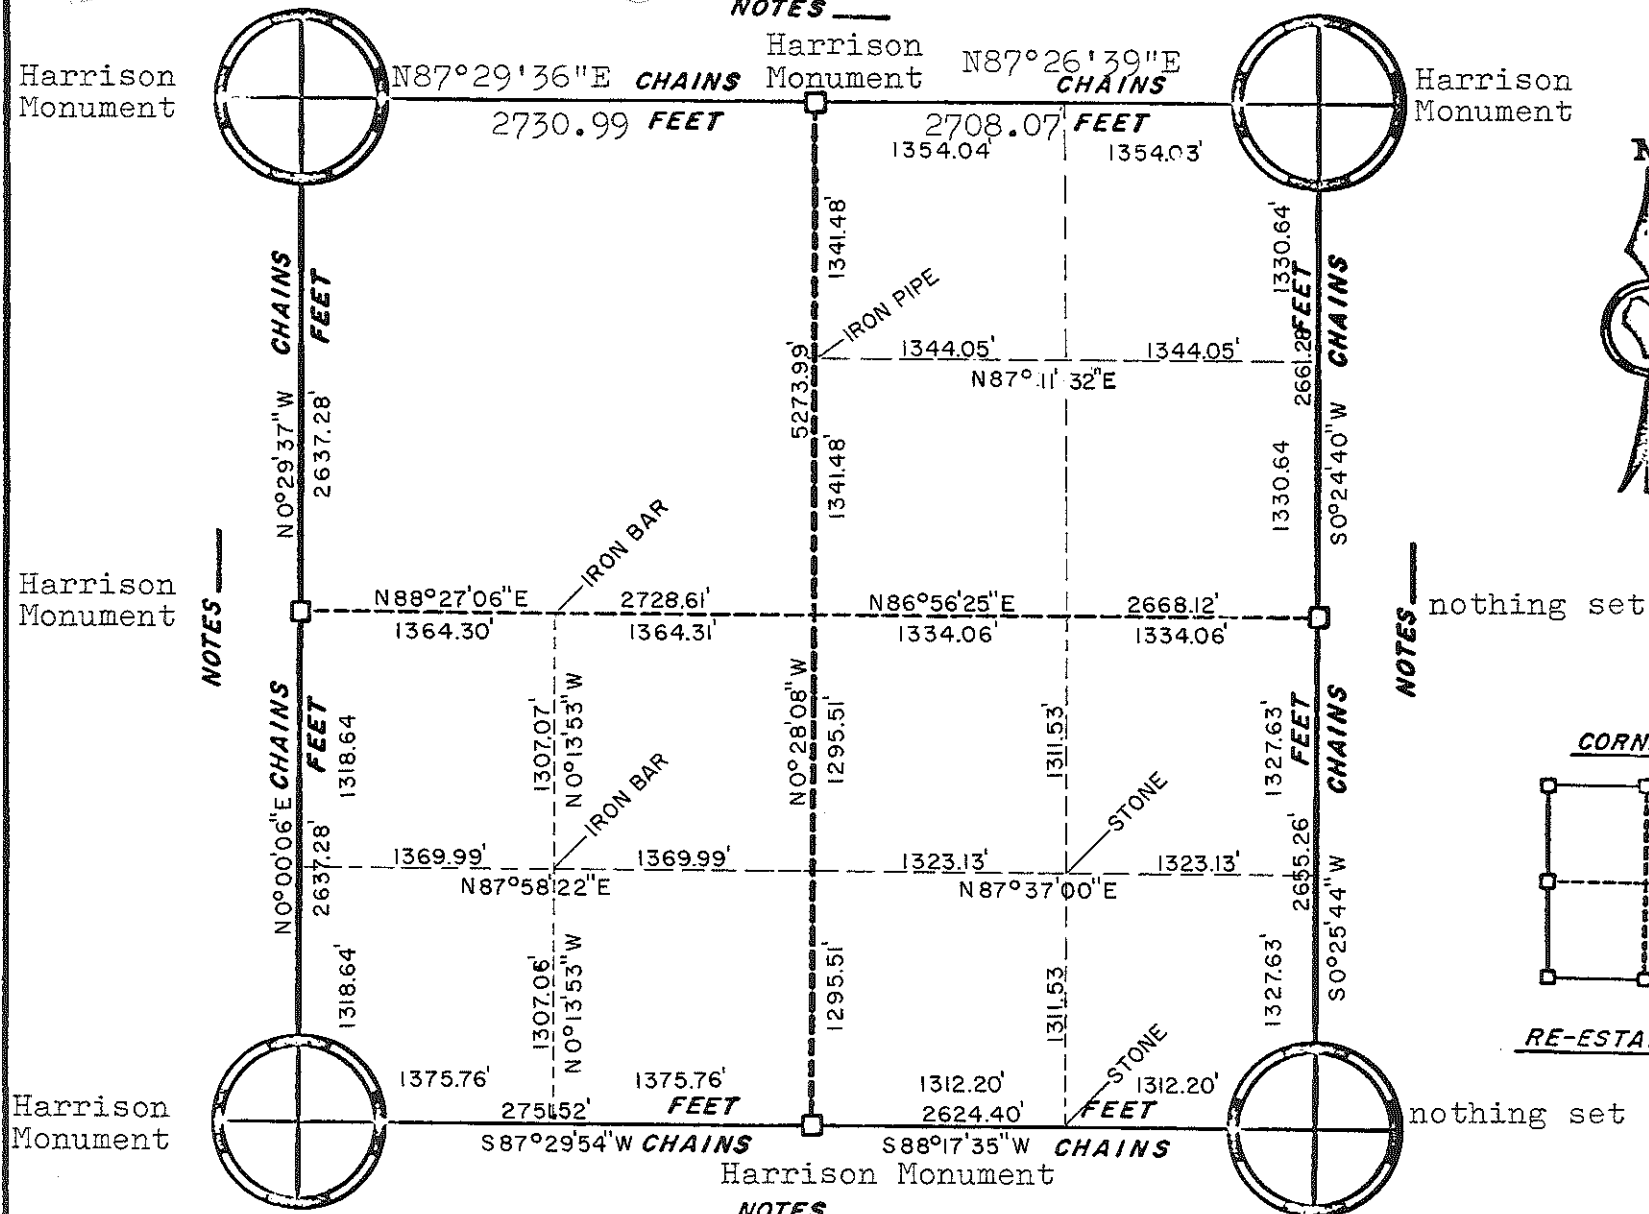


NOTES \_\_\_\_\_

NOTES \_\_\_\_\_

nothing set

nothing set

CORNERS

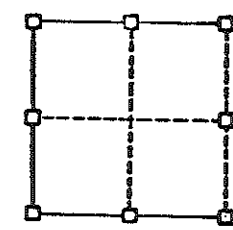


RE-ESTABLISHED

ORIGINAL SURVEY DATA


BY \_\_\_\_\_  
DATE 3/18/81

SURVEYED BY H. A. Sime	CONTRACT DATE January, 1980	COUNTY MONROE [REDACTED]	TOWN- <del>VILLAGE CITY</del> Clifton	SECTION 16	TOWNSHIP T16N	RANGE R1E
---------------------------	--------------------------------	-----------------------------	--	---------------	------------------	--------------

NOTES \_\_\_\_\_

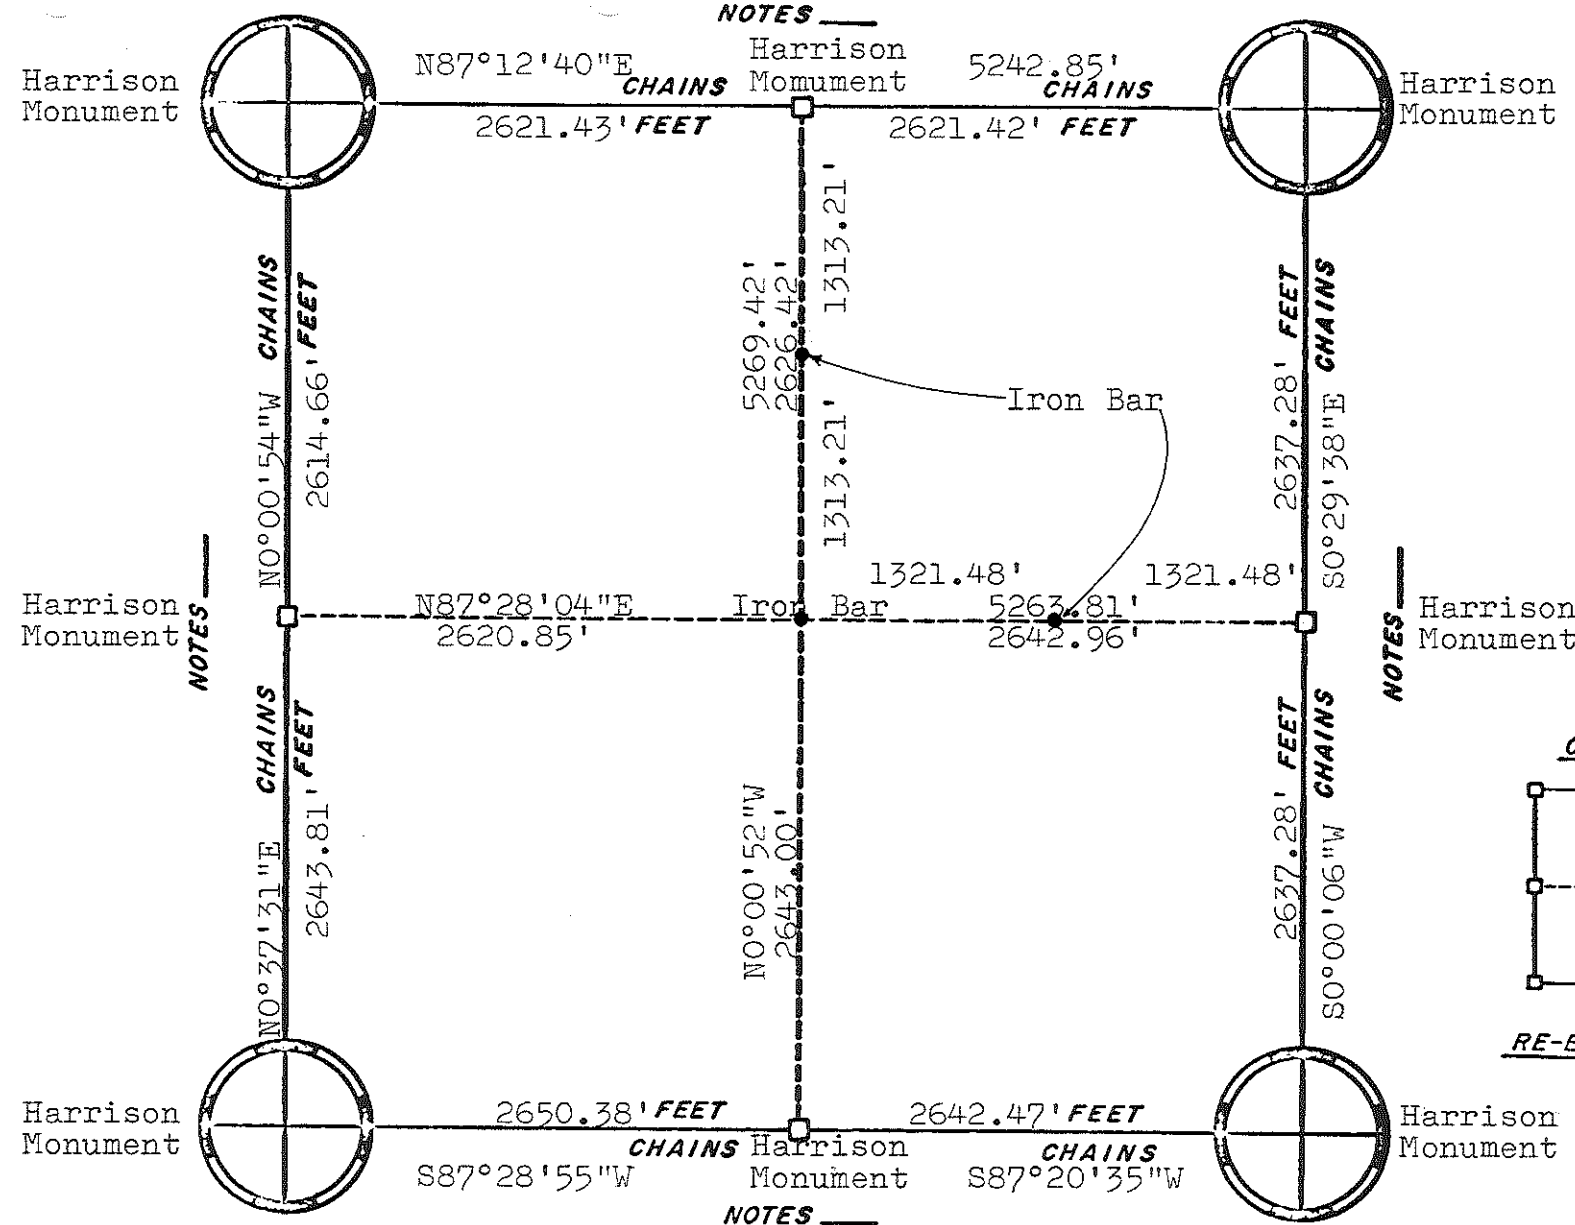

NOTES \_\_\_\_\_

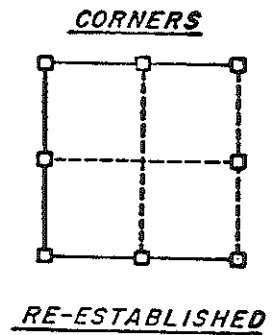


ORIGINAL SURVEY DATA


BY \_\_\_\_\_  
DATE 3/18/81

SURVEYED BY H. A. Sime	CONTRACT DATE March, 1980	COUNTY MONROE	TOWN- <del>CLIFTON</del> Clifton	SECTION 17	TOWNSHIP T16N	RANGE R1E
---------------------------	------------------------------	---------------	-------------------------------------	---------------	------------------	--------------


NOTES \_\_\_\_\_

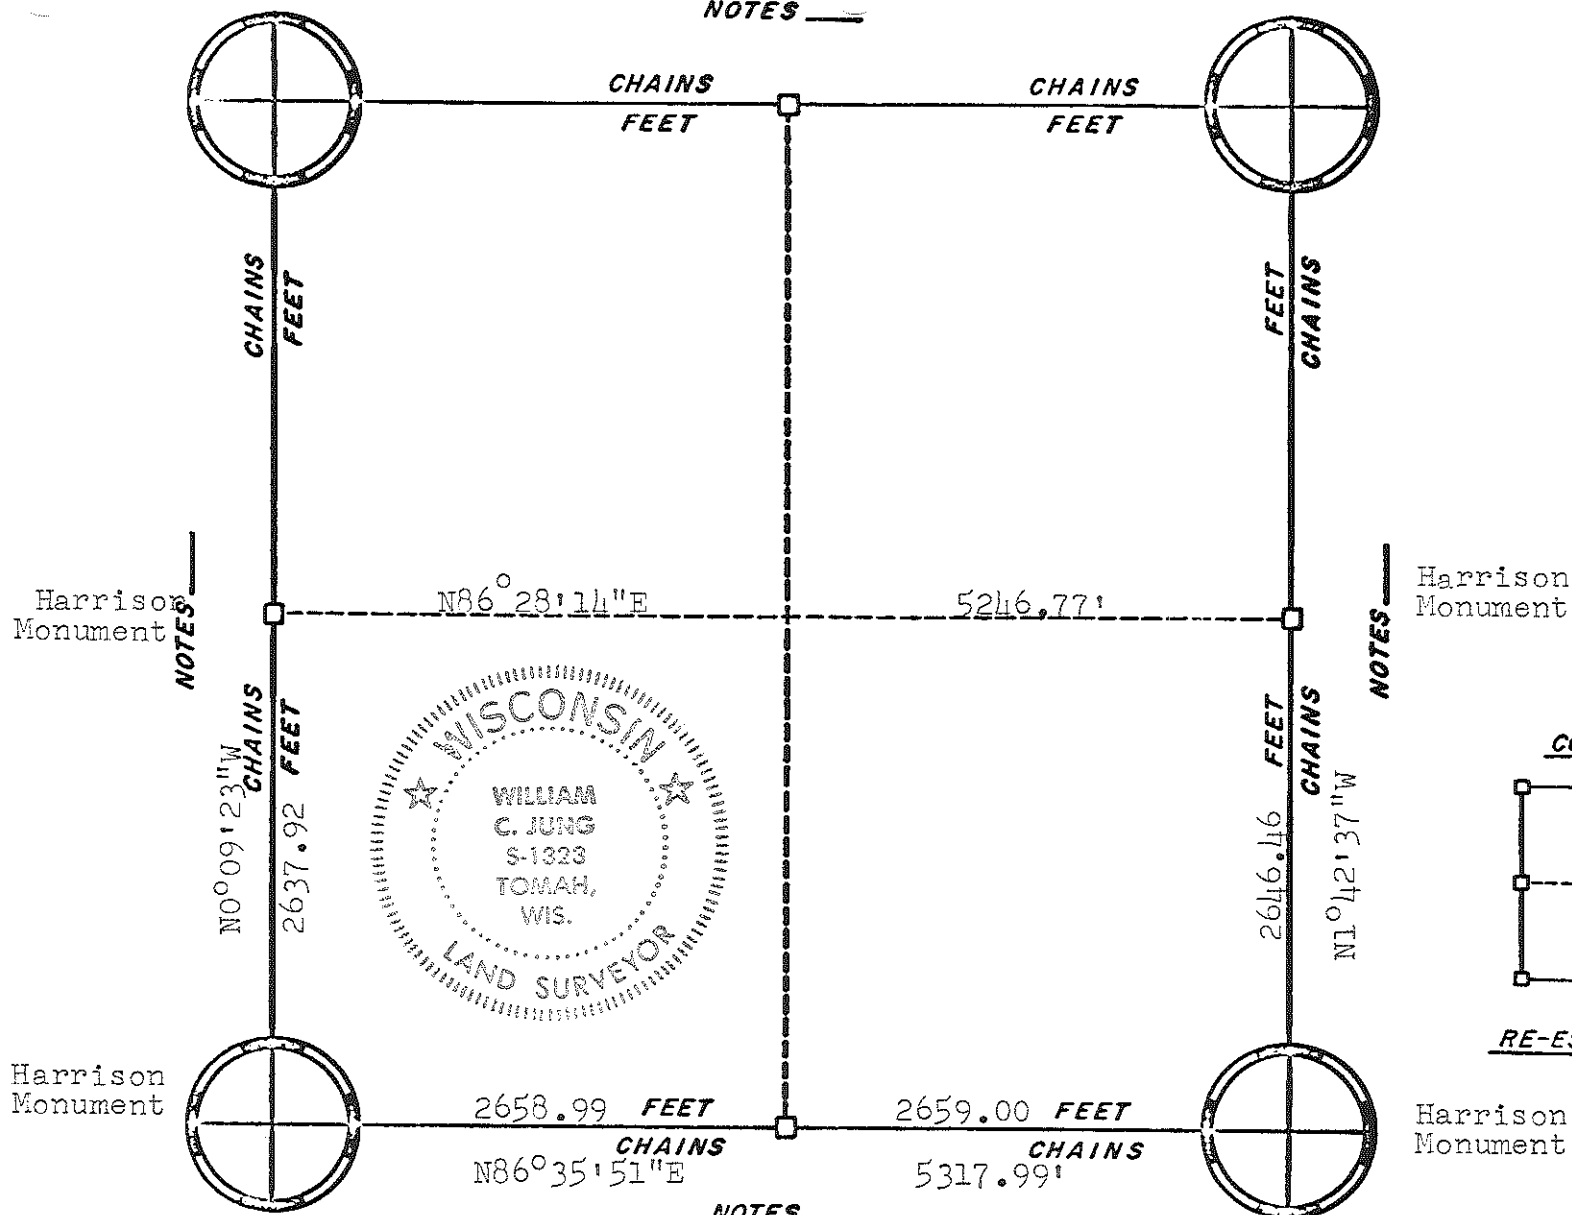

Harrison Monument

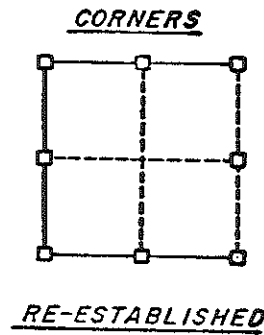

Harrison Monument

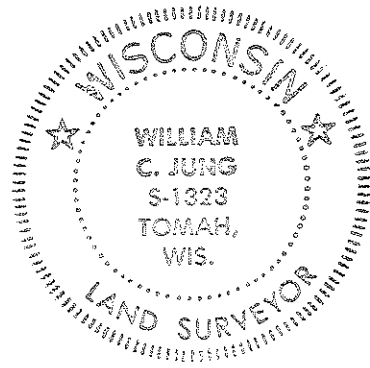



**ORIGINAL SURVEY DATA**

BY *wcj*


DATE 3/5/79

SURVEYED BY W. C. Jung	CONTRACT DATE August 1976	COUNTY MONROE	TOWN-VILLAGE-CITY Clifton	SECTION 23	TOWNSHIP 16N	RANGE 1E
---------------------------	------------------------------	---------------	------------------------------	---------------	-----------------	-------------

NOTES \_\_\_\_\_

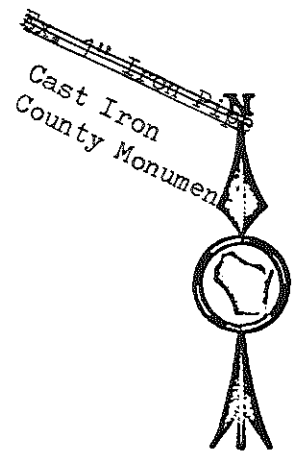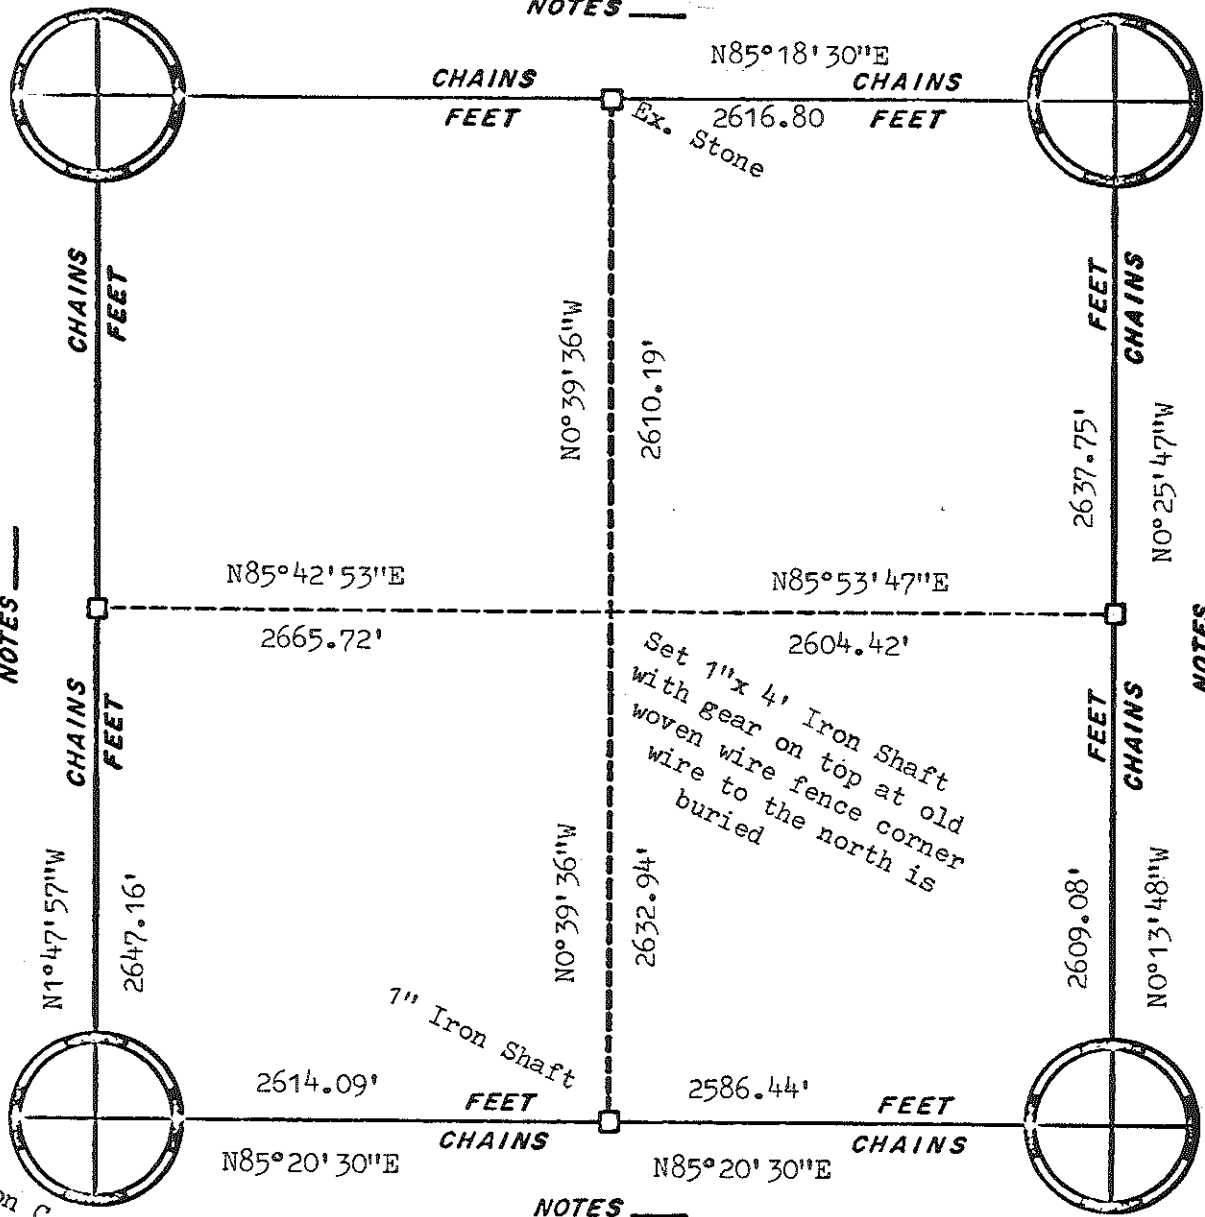

CORNERS

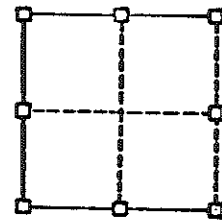

RE-ESTABLISHED

Cast Iron County Monument

BY \_\_\_\_\_

DATE \_\_\_\_\_


ORIGINAL SURVEY DATA

SURVEYED BY Gary L. Dechant	CONTRACT DATE April 27, 2006	COUNTY MONROE [REDACTED]	TOWN-VILLAGE-CITY Clifton	SECTION 24	TOWNSHIP 16 N	RANGE 1 E
--------------------------------	---------------------------------	-----------------------------	------------------------------	---------------	------------------	--------------




NOTES \_\_\_\_\_

Harrison Monument

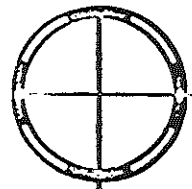

Harrison Monument 5317.99'  
 $N86^{\circ}35'51''E$  2658.99 FEET 2659.00 FEET

Harrison Monument

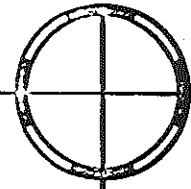

$N0^{\circ}03'04''W$   
 2665.36 FEET

5265.14'

2623.18 FEET  
 $N0^{\circ}05'43''E$


Harrison Monument

NOTES \_\_\_\_\_


$N86^{\circ}08'21''E$  Iron Bar in Iron Pipe 5313.92'

Harrison Monument

NOTES \_\_\_\_\_

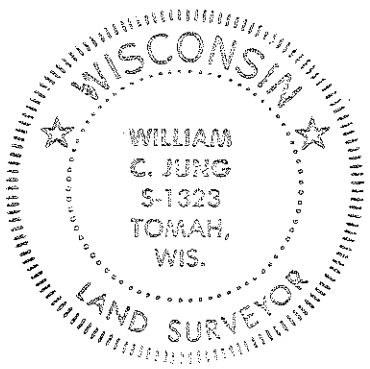


$N0^{\circ}04'16''E$

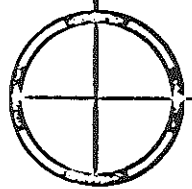


FEET CHAINS FEET

Harrison Monument  
 NOTES \_\_\_\_\_

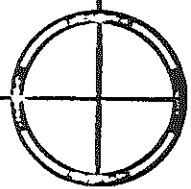

CORNERS

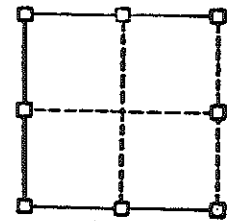

RE-ESTABLISHED



ORIGINAL SURVEY DATA

BY *wcj*

DATE 3/5/79

SURVEYED BY W. C. Jung	CONTRACT DATE June 1976	COUNTY MONROE	TOWN-VILLAGE-CITY Clifton	SECTION 26	TOWNSHIP 16N	RANGE 1E
---------------------------	----------------------------	---------------	------------------------------	---------------	-----------------	-------------

NOTES \_\_\_\_\_

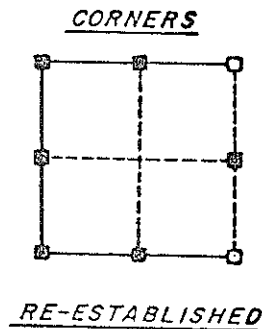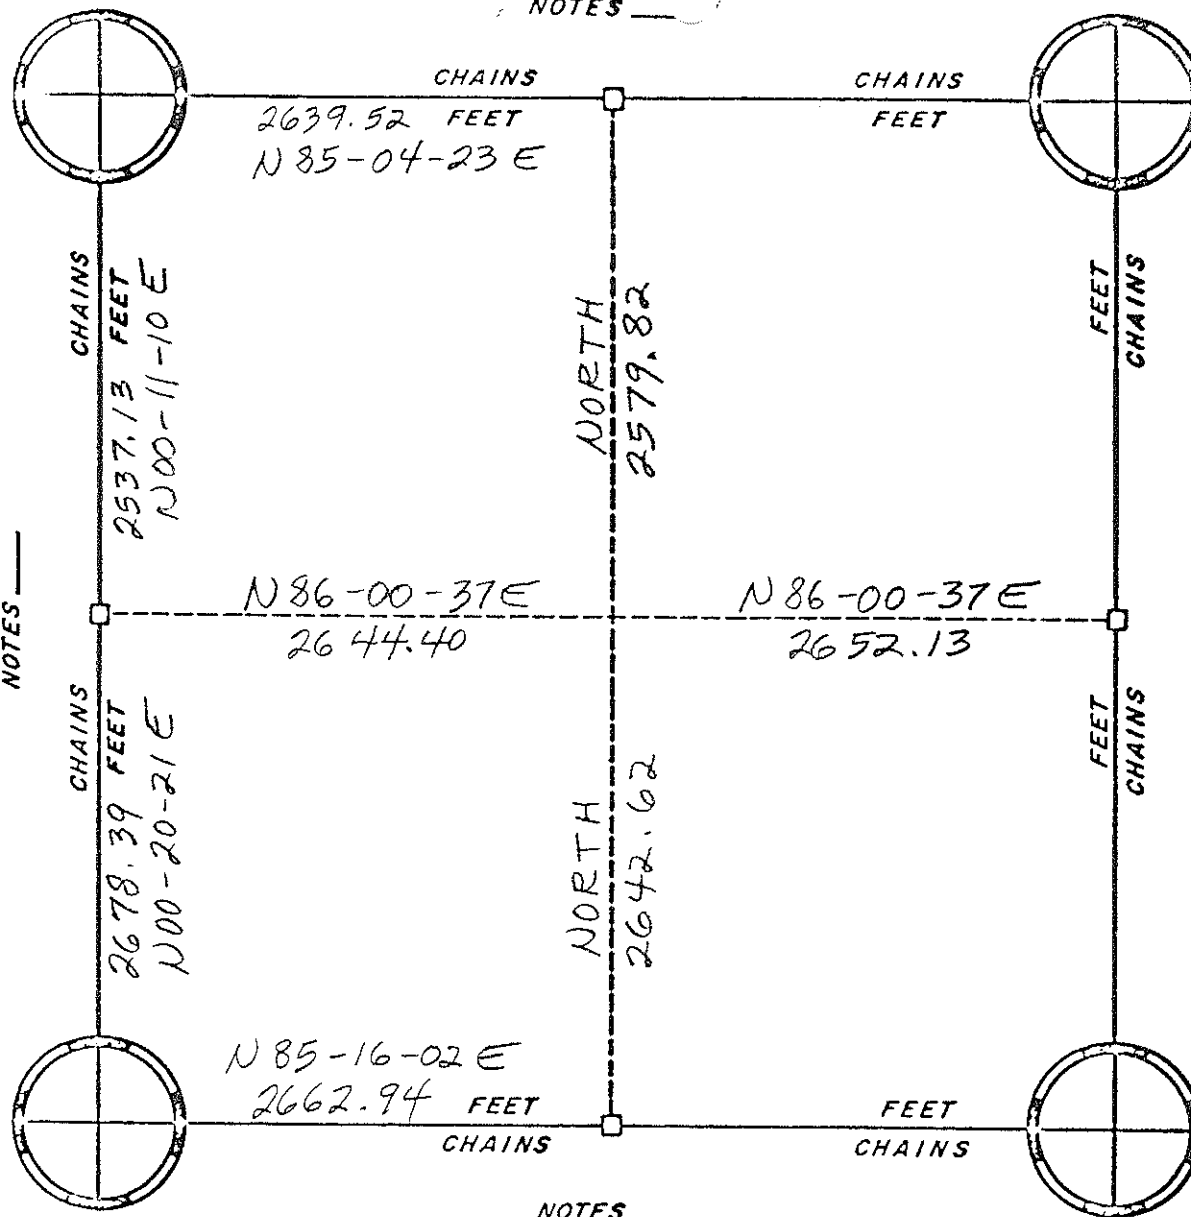

NOTES \_\_\_\_\_


ORIGINAL SURVEY DATA

BY \_\_\_\_\_  
DATE \_\_\_\_\_

SURVEYED BY J. Carroll	CONTRACT DATE 12/10/83	COUNTY MONROE [REDACTED]	TOWN-VILLAGE-CITY CLIFTON	SECTION 27	TOWNSHIP 16	RANGE 1 E
---------------------------	---------------------------	-----------------------------	------------------------------	---------------	----------------	--------------


Section Summary and Index

27 - 16 - 1E  
 Section Town Range

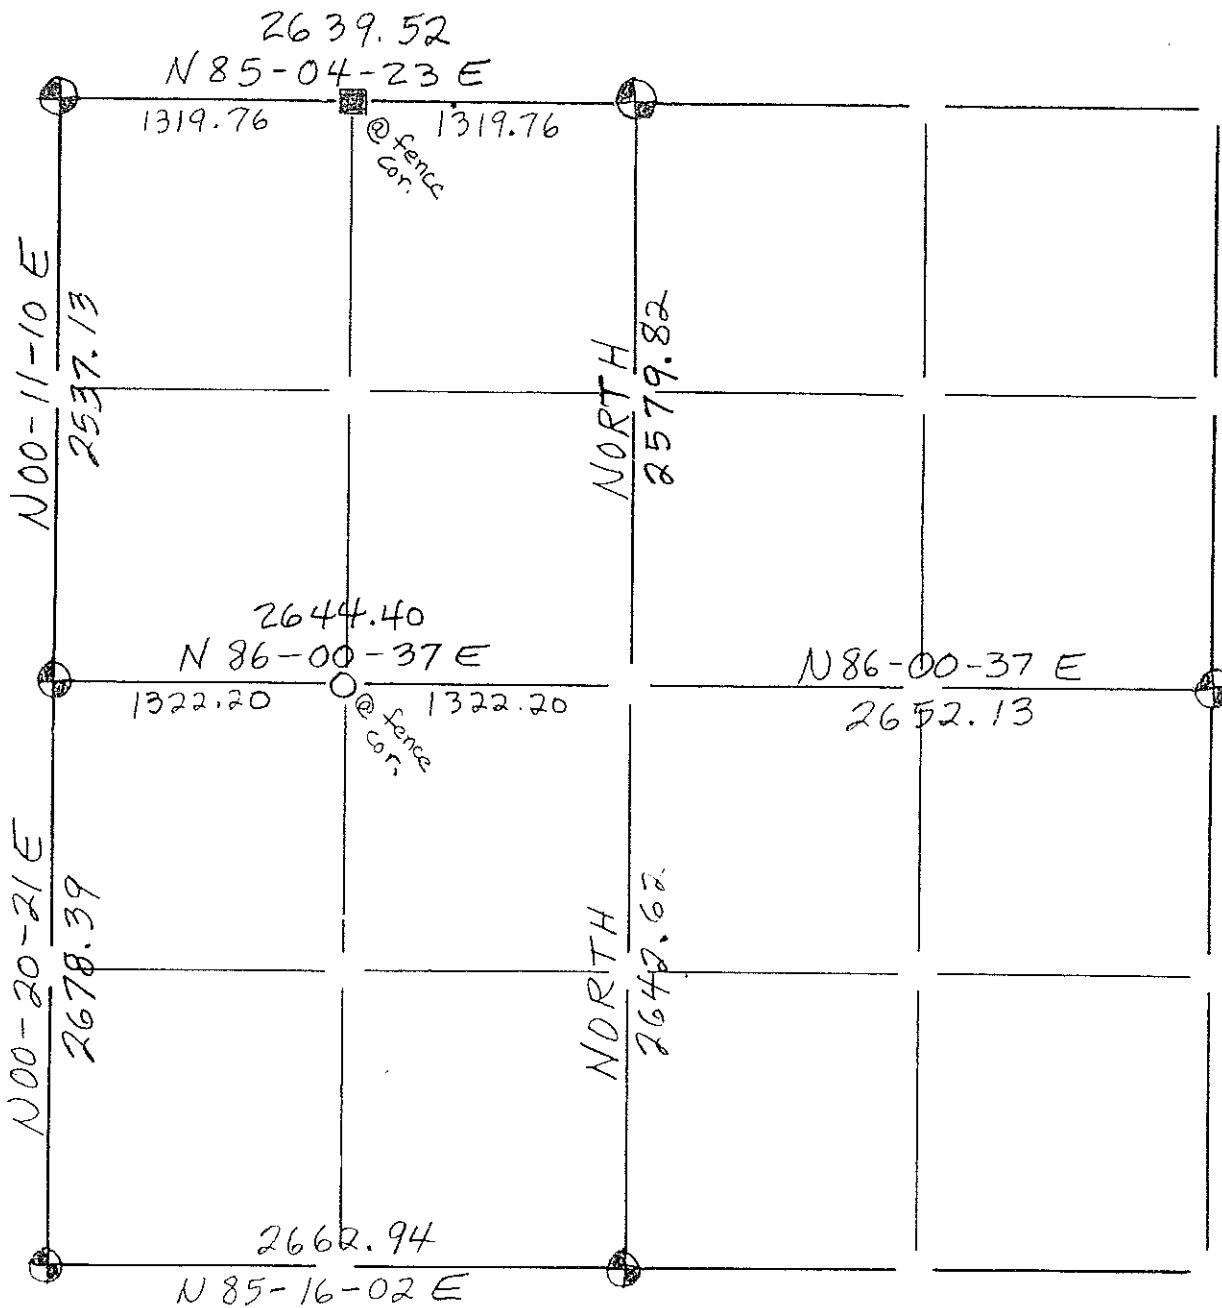


LEGEND

- ⊙ - Harrison cast iron monument.
- - Stone ~~or concrete~~ monument.
- - Other 1" iron pipe set  
at old fence corner  
post recognized as the  
forty corner.

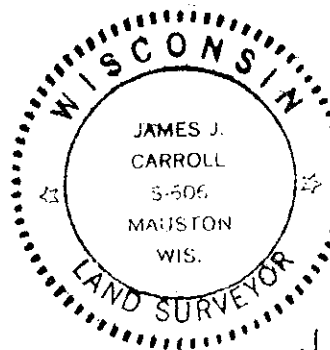


5/28/84

NOTES 86.7

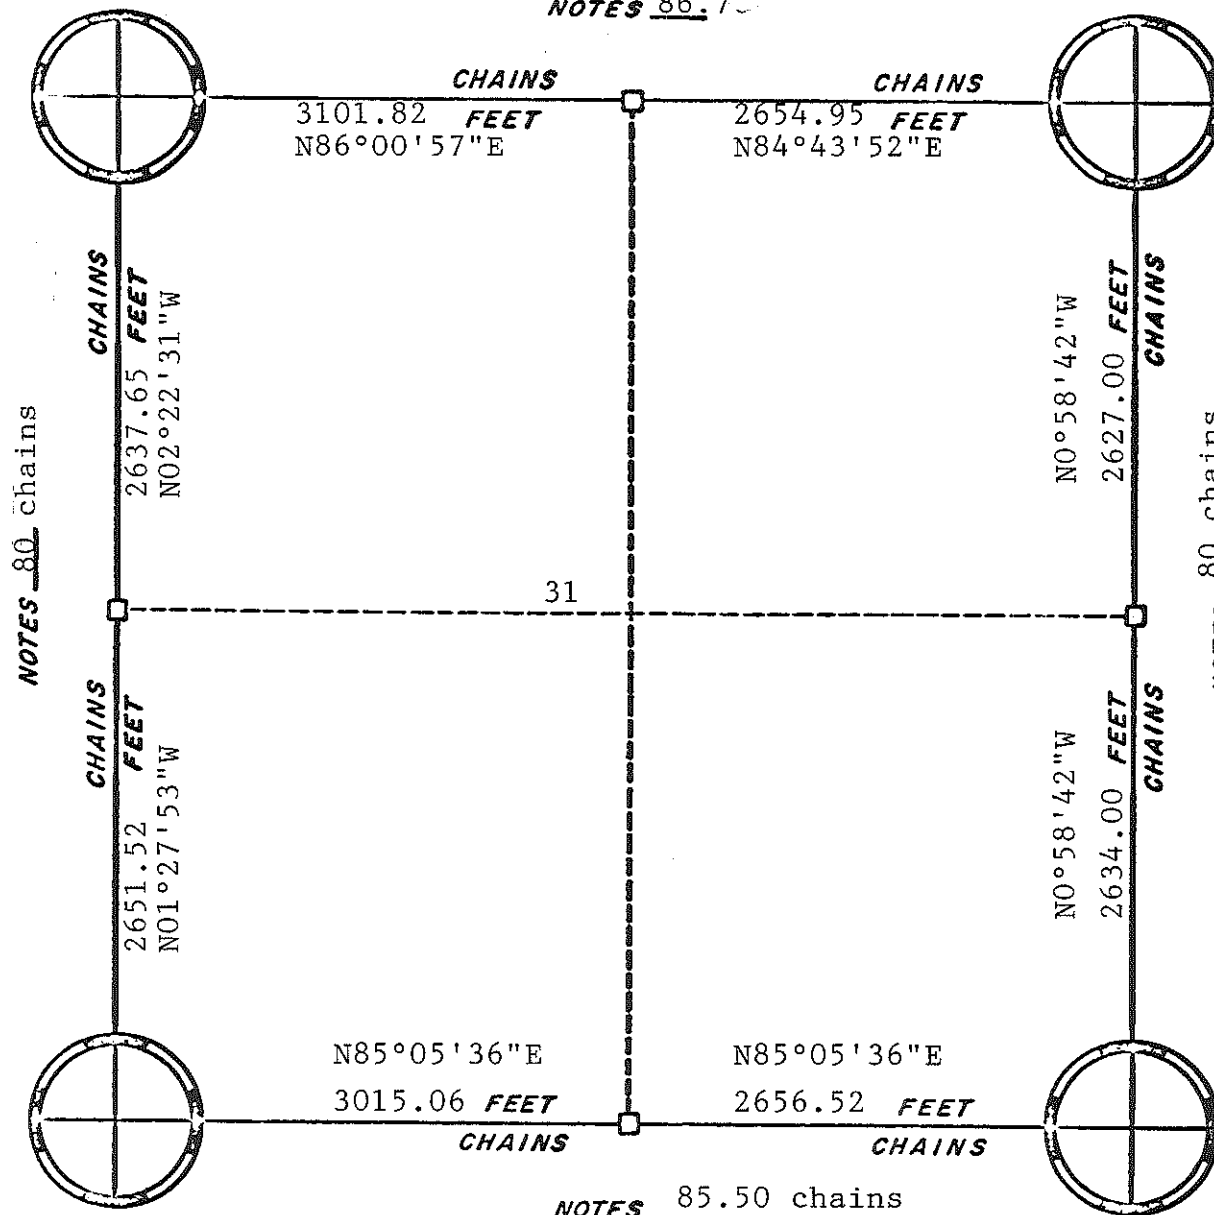

Harrison Monuments  
at all corners

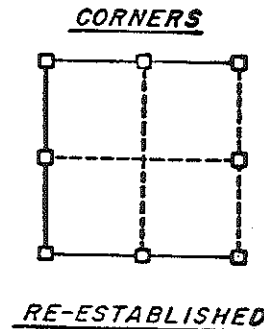


NOTES 85.50 chains

ORIGINAL SURVEY DATA

BY \_\_\_\_\_  
DATE Jan. 1989

SURVEYED BY Feddersen & Dechant	CONTRACT DATE	COUNTY MONROE	TOWN-VILLAGE-CITY	SECTION	TOWNSHIP	RANGE
			Clifton			

NOTES 5293.2

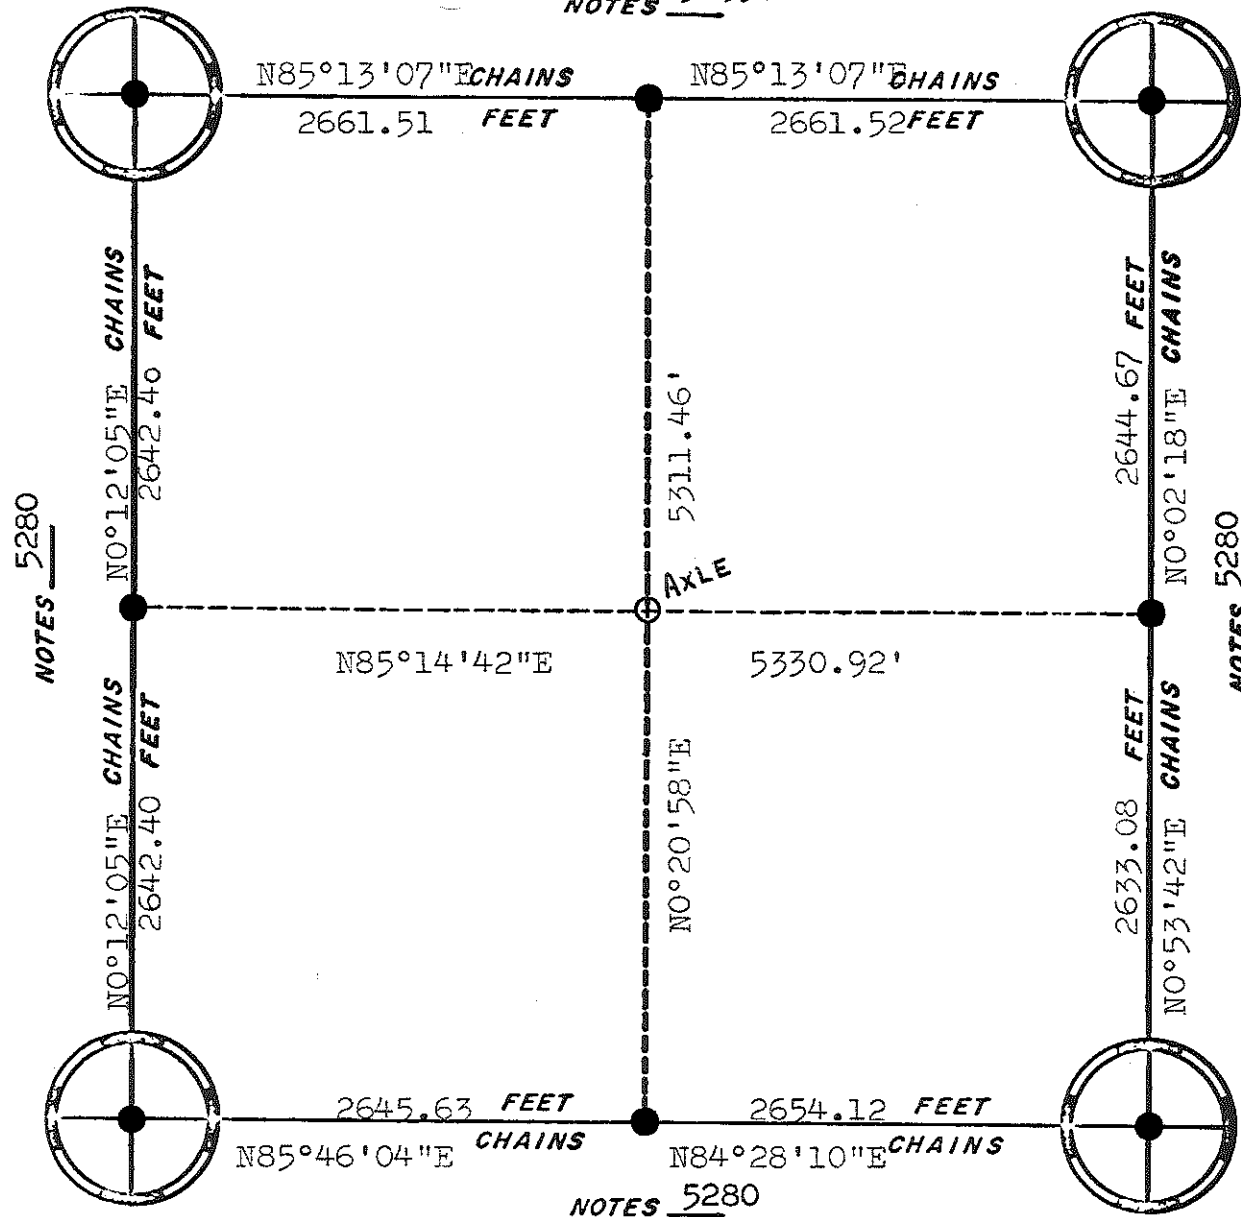


NOTES 5280

NOTES 5280

NOTES 5280



● = Set Harrison

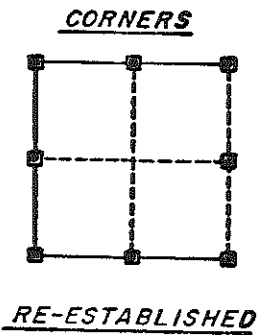


ORIGINAL SURVEY DATA


BY \_\_\_\_\_  
DATE 1/13/82

SURVEYED BY Sime&Associates	CONTRACT DATE Oct. 31, 1981	COUNTY MONROE	TOWN-VILLAGE-CITY Clifton	SECTION 34	TOWNSHIP 16N	RANGE 1E
--------------------------------	--------------------------------	------------------	------------------------------	---------------	-----------------	-------------

NOTES 5297.16

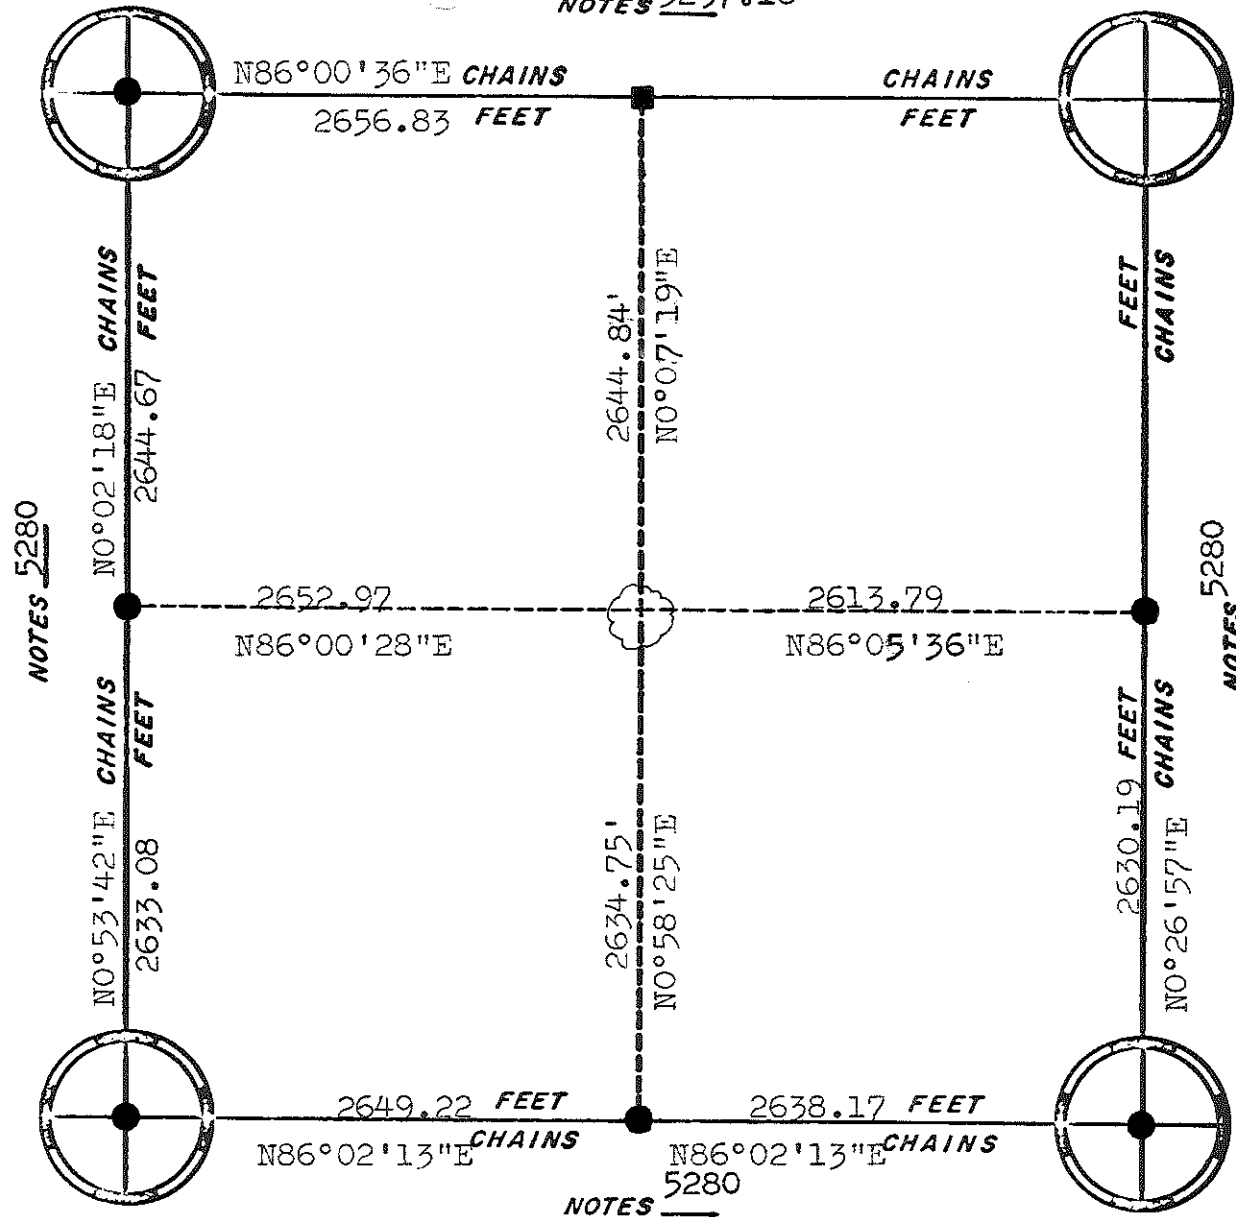

- =Set Harrison
- =Ex. Harrison
- ☁ =Living corner, large Black Oak

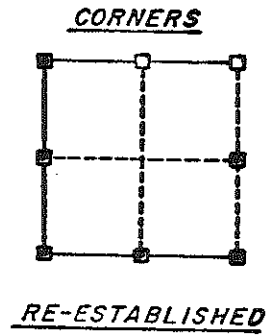

ORIGINAL SURVEY DATA

BY \_\_\_\_\_  
DATE 1/13/82

SURVEYED BY Sime&Associates	CONTRACT DATE Nov. 2, 1981	COUNTY MONROE	TOWN-VILLAGE-CITY Clifton	SECTION 35	TOWNSHIP 16N	RANGE 1E
--------------------------------	-------------------------------	------------------	------------------------------	---------------	-----------------	-------------