

CERTIFICATE

I, Harley A. Sime, do hereby certify that on the sixth day of May 1981, I found (evidence) ~~no evidence~~ of the Center 1/4 corner of Section 5, T 16 N, R 1 W Fourth Principal Meridian, and I re-established said corner according to the Wisconsin Statutes as shown and described hereon.

Dated this 14th day of August 1981.

Harley A. Sime

Monroe County Surveyor

Title

Approved: **HARLEY A. SIME**

**MONROE CO. SURVEYOR**

Description of corner and witness monuments, references and accessories used to perpetuate the original or re-established location of this corner:

Witnesses to corner location:

Bryan H. Meyer - Crew Chief

Gary L. Dechant

COUNTY SURVEYOR FORM NO. 1

CERTIFIED LAND CORNER

No. 15 A

**21601052020**



History of corner establishment since Original Government Survey

O.R. Dahl was here in June of 1868.

Description of corner evidence found:

Accepted three-way fence corner as the best available evidence.

North

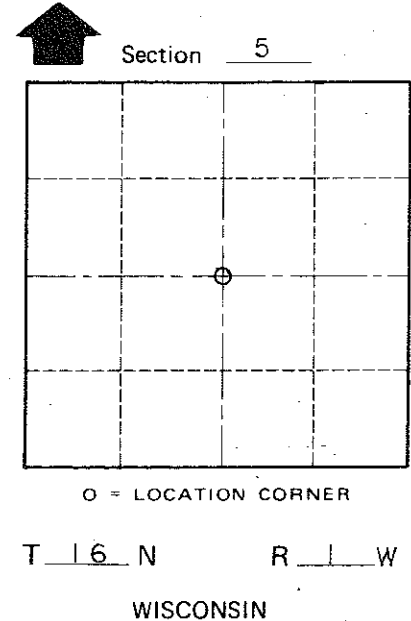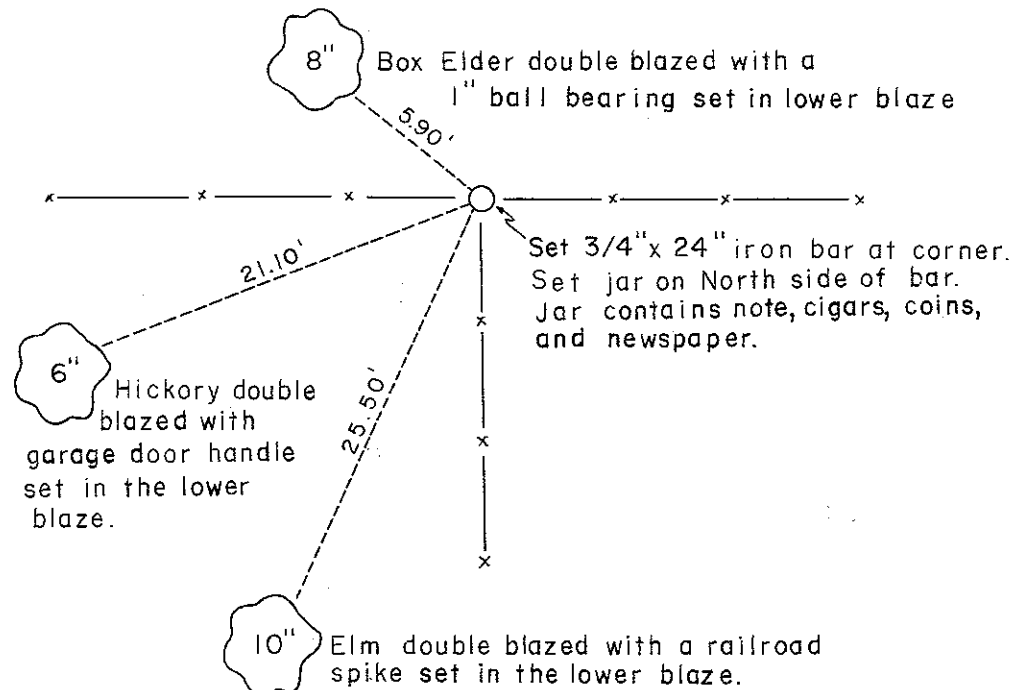

SURVEY CONTROL ORDER

Horizontal	_____
Vertical	_____

WISCONSIN COORDINATE SYSTEM

Corner	East (X)	North (Y)	Elevation (Z)	Zone
Control Sta. Name				

~~City Village or~~ Town of Wilton  
County of Monroe