

21601170000

I, Bryan H. Meyer, do hereby certify that on the 4th day of May 1983, I found (evidence) ~~XXXXXXXXXX~~ of the Southeast corner of Section 17, T 16 N, R 1 W Fourth Principal Meridian, and I re-established said corner according to the Wisconsin Statutes as shown and described hereon.

Dated this 6th day of May 1983.

Bryan H. Meyer
Deputy County Surveyor

History of corner establishment since Original Government Survey

Harley Sime was here in June of 1962 and set an iron pipe off an Original Government bearing tree.

Description of corner evidence found:

Found Sime's iron pipe, up 4"±. The Original bearing tree is gone.

Approved: **HARLEY A. SIME**
MONROE CO. SURVEYOR

Description of corner and witness monuments, references and accessories used to perpetuate the original or re-established location of this corner:
Date: May 4, 1983 - 2:30 P.M.
Weather: Windy, P. Cloudy, 60°±



Witnesses to corner location:

Bryan H. Meyer

Dallas Wilhite

Replaced Sime's iron pipe with a Harrison monument, up 2"±.

The 4 bearing trees shown are double blazed with each distance to a nail in a hack on the side of the tree.

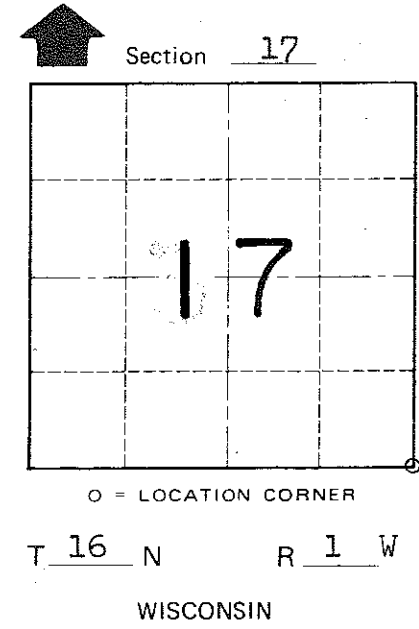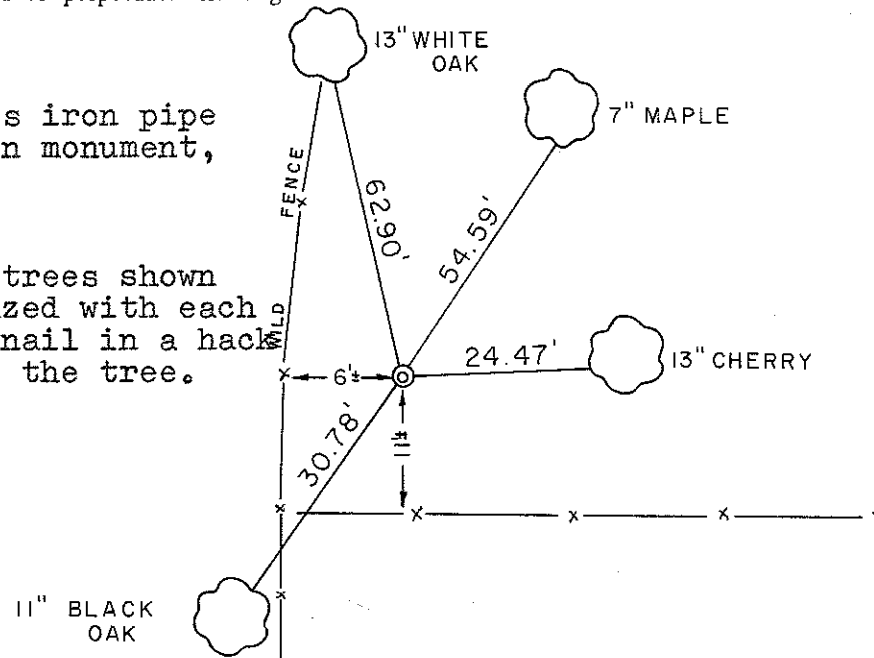

COUNTY SURVEYOR FORM NO. 1

SURVEY CONTROL ORDER

Horizontal	_____
Vertical	_____

WISCONSIN COORDINATE SYSTEM

Corner	East (X)	North (Y)	Elevation (Z)	Zone
Control Sta. Name				

~~City, Village or~~ Town of Wilton
County of Monroe