

CERTIFICATE

CERTIFIED LAND CORNER

No. 77

21601212000

I, Garold A. Sime, do hereby certify that on the 26th day of June 19 86, I found (evidence) ~~no evidence~~ of the W¹/₄ corner of Section 22, T16 N, R 1W Fourth Principal Meridian, and I re-established said corner according to the Wisconsin Statutes as shown and described hereon.

History of corner establishment since Original Government Survey

No recorded history since the Original Government Survey.

Description of corner evidence found:

Accepted existing 3-way fence corner as best available evidence

Dated this 29th day of Dec 19 86.

Garold A. Sime

Deputy County Surveyor

Title

COUNTY SURVEYOR FORM NO. 1

Description of corner and witness monuments, references and accessories used to perpetuate the original or re-established location of this corner:

Set Harrison Monument at corner


Witnesses to corner location:

Garold A. Sime, R.L.S.


Bryan H. Meyer, R.L.S.

Dallas Wilhite

Joel Tralmer

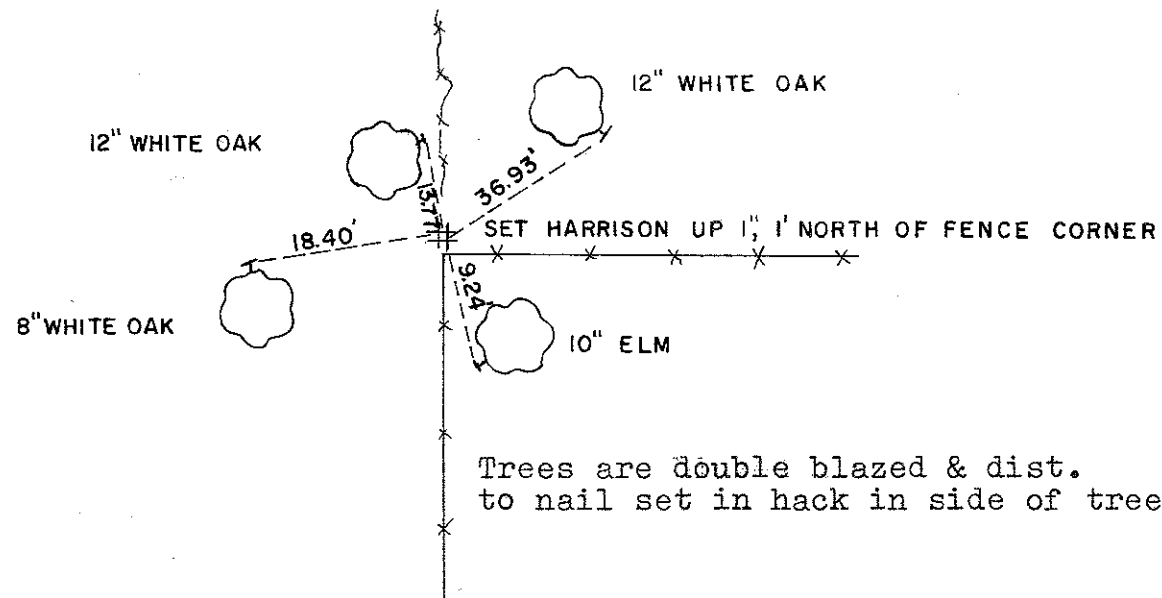

Trees are double blazed & dist. to nail set in hack in side of tree

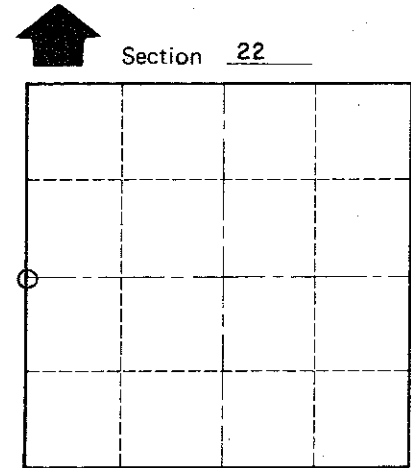

O = LOCATION CORNER

T 16 N R 1W

WISCONSIN

SURVEY CONTROL ORDER

Horizontal	_____
Vertical	_____

WISCONSIN COORDINATE SYSTEM

Corner	East (X)	North (Y)	Elevation (Z)	Zone
Control Sta. Name				

City, Village or Town Wilton

County of Monroe