

21601290000

I, Harley A. Sime, do hereby certify that on the 17th day of March 19 78, I found (evidence) (~~no evidence~~) of the NE corner of Section 32, T 16 N, R 1 W, Fourth Principal Meridian, and I re-established said corner according to the Wisconsin Statutes as shown and described hereon.

Dated this 14th day of Feb. 19 79.

Harley Sime

County Surveyor

Title

History of original corner establishment:

No known recorded history since the original government survey.

Description of corner evidence found:

D. Marten accepted an existing 2-way fence corner as best available evidence and set a Harrison Monument in June of 1973.


Approved: **HARLEY A. SIME**
MONROE CO. SURVEYOR

Description of corner and witness monuments, references and accessories used to perpetuate the original or re-established location of this corner:

Witnesses to corner location:

C. Pietz, Crew Chief

G. Dechant

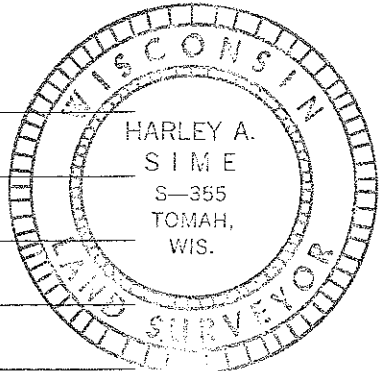

SIGN PLACED 9-20-90 J. Sime

Existing Harrison



6"x8"x5' wood post


189.45' (SLOPE CHAINED)

14" Elm

235.05' (SLOPE CHAINED)

8" double Elm

(All trees double blazed and with nail & cap.)

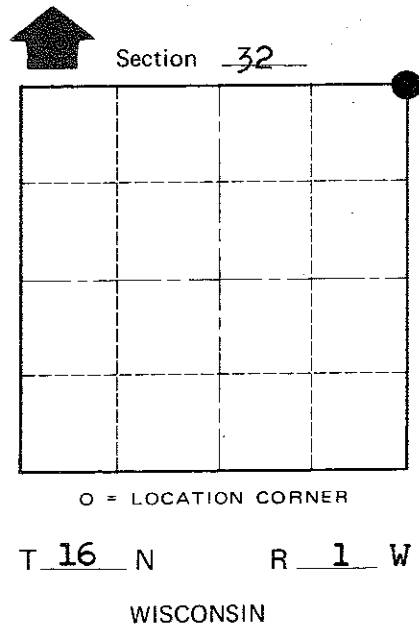

COUNTY SURVEYOR FORM NO. 1

SURVEY CONTROL ORDER

Horizontal	_____
Vertical	_____

WISCONSIN COORDINATE SYSTEM

Corner	East (X)	North (Y)	Elevation (Z)	Zone
Control Sta. Name				

City, Village or Town Wilton

County of Monroe