

CERTIFICATE

CERTIFIED LAND CORNER

No. 111

21601300000

I, Harley A. Sime, do hereby certify that on the 17th day of March 1978, I found (evidence) (~~no evidence~~) of the NW corner of Section 32, T 16 N, R 1 W Fourth Principal Meridian, and I re-established said corner according to the Wisconsin Statutes as shown and described hereon.

History of original corner establishment:

A Surveyor was here in June of 1895.

Description of corner evidence found:

D. Marten set Harrison Monument by a stone in an existing 2-way fence as best available evidence. Marten set the corner in June of 1973.

Dated this 20th day of March 1978.

Harley Sime

County Surveyor

Title


Approved: **HARLEY A. SIME**
MONROE CO. SURVEYOR

Description of corner and witness monuments, references and accessories used to perpetuate the original or re-established location of this corner:

Witnesses to corner location:

C. Pietz, Crew Chief

G. Dechant

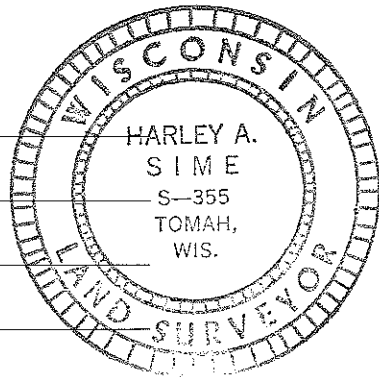

39" double White Oak



108.58' (SLOPE CHAINED)

North



Existing Harrison

6" Aspen




15.75'

6" Black Oak



35.17'

(All trees double blazed and with nail & cap)

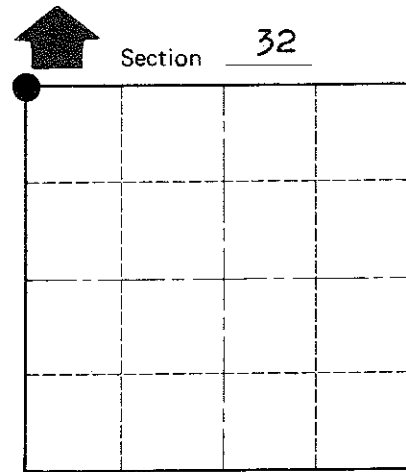

O = LOCATION CORNER

T 16 N R 1 W
WISCONSIN

SURVEY CONTROL ORDER

Horizontal _____

Vertical _____

WISCONSIN COORDINATE SYSTEM

Corner	East (X)	North (Y)	Elevation (Z)	Zone
Control Sta. Name				

City, Village or Town Wilton

County of Monroe

COUNTY SURVEYOR FORM NO. 1