

21601340020

I, Harley A. Sime, do hereby certify that on the 29th day of September 1980, I found ~~(no evidence)~~ (no evidence) of the South 1/4 corner of Section 34, T 16 N, R 1 W Fourth Principal Meridian, and I re-established said corner according to the Wisconsin Statutes as shown and described hereon.
 Dated this 29th day of Sept. 1980

History of corner establishment since Original Government Survey
 NO known recorded history since the original government survey.

Description of corner evidence found:
 Accepted fence corner as best available evidence.



Approved: HARLEY A. SIME
MONROE CO. SURVEYOR
 Title

COUNTY SURVEYOR FORM NO. 1

Description of corner and witness monuments, references and accessories used to perpetuate the original or re-established location of this corner:

Witnesses to corner location:

G. Dechant
B. Meyer
S. Sowers

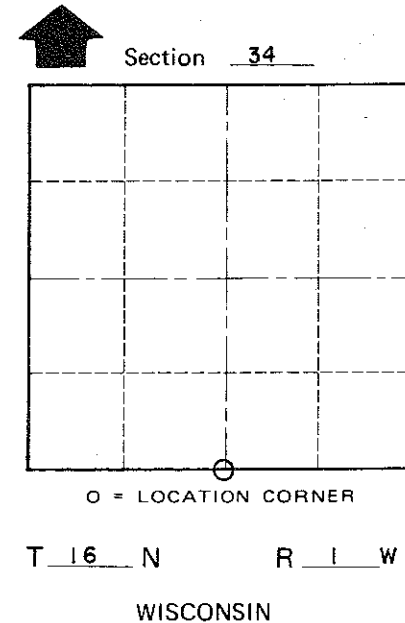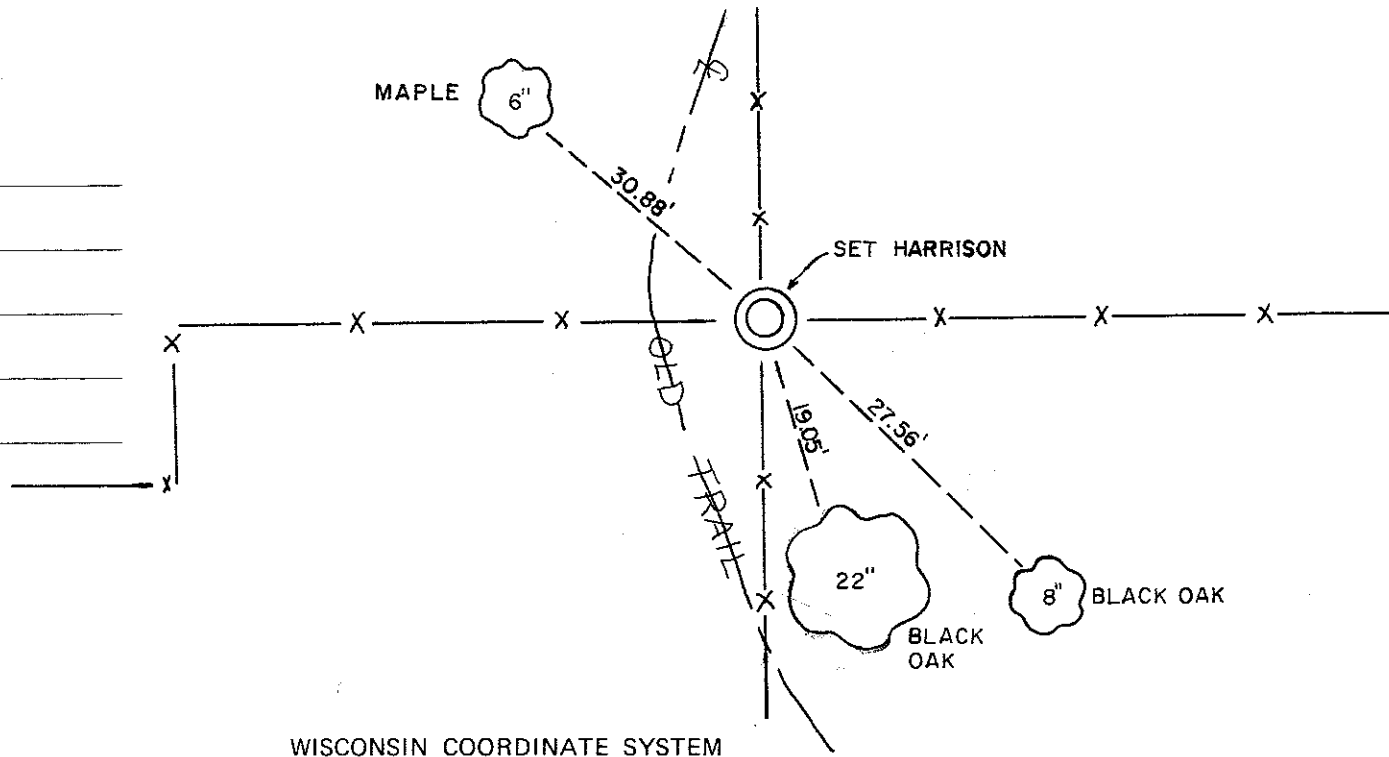

SURVEY CONTROL ORDER

Horizontal	_____
Vertical	_____

WISCONSIN COORDINATE SYSTEM

Corner	East (X)	North (Y)	Elevation (Z)	Zone
Control Sta. Name				

~~City, Village or~~ Town of Wilton
 County of Monroe
Wisconsin