

21601342020

I, Harley A. Sime, do hereby certify that on the twenty-sixth day of September 19 80, I found ~~(no evidence)~~ (no evidence) of the Center 1/4 corner of Section 34, T 16 N, R 1 W Fourth Principal Meridian, and I re-established said corner according to the Wisconsin Statutes as shown and described hereon.

History of corner establishment since Original Government Survey

No known recorded history since the original government survey.

Description of corner evidence found:

Intersected N-S 1/4 line with E-W 1/4 line.

Dated this 26th day of Sept 1980.


Approved: HARLEY A. SIME
MONROE CO. SURVEYOR
Title

COUNTY SURVEYOR FORM NO. 1


Description of corner and witness monuments, references and accessories used to perpetuate the original or re-established location of this corner:

Witnesses to corner location:

- G. Dechant
- B. Meyer
- C. Dade

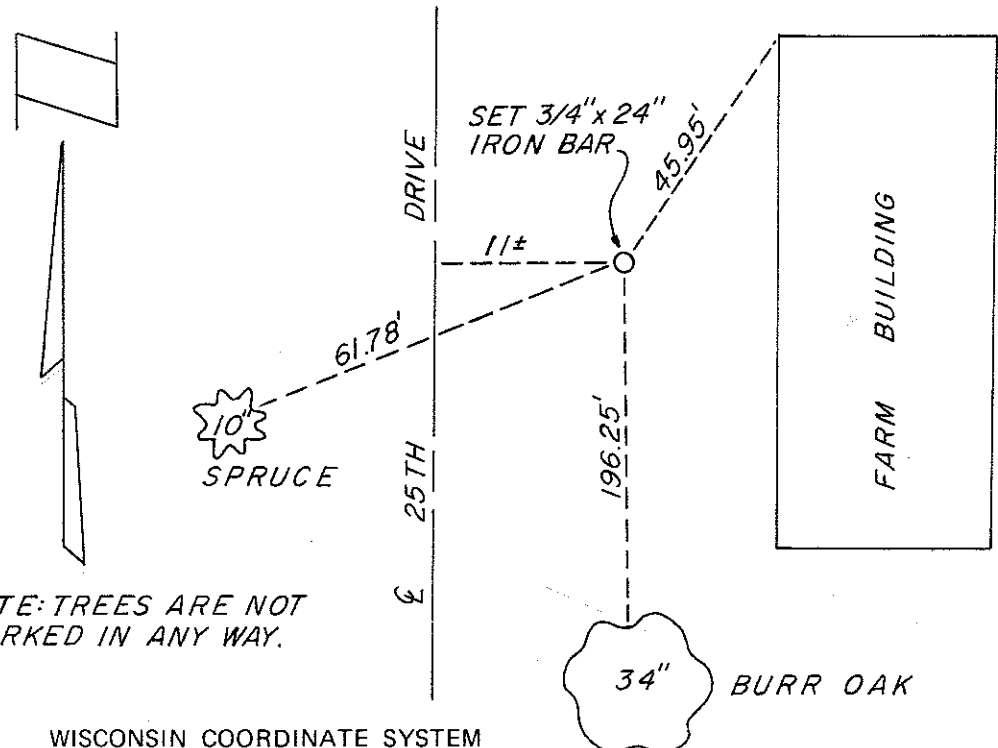

NOTE: TREES ARE NOT MARKED IN ANY WAY.

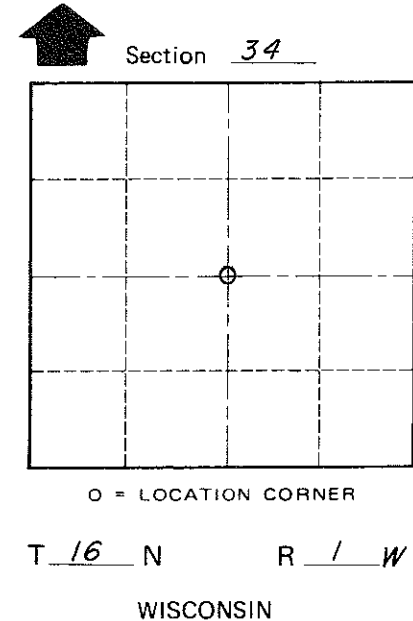

SURVEY CONTROL ORDER

Horizontal	_____
Vertical	_____

WISCONSIN COORDINATE SYSTEM

Corner	East (X)	North (Y)	Elevation (Z)	Zone
Control Sta. Name				

City, Village or Town of Wilton
County of Monroe
Wisconsin