
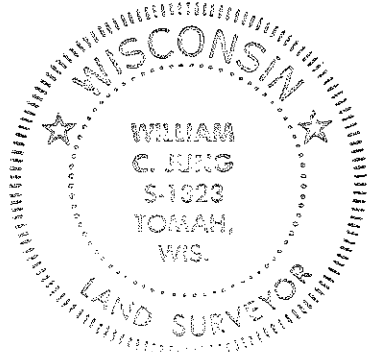


ORIGINAL SURVEY DATA

BY _____
DATE _____


| SURVEYED BY | CONTRACT DATE | COUNTY | MONROE | TOWN-VILLAGE-CITY | SECTION | TOWNSHIP | RANGE |
|-------------|----------------|--------|--------|-------------------|---------|----------|-------|
| | March 11, 1981 | | | Ridgeville | 2 | 16N | 2W |

NOTES _____

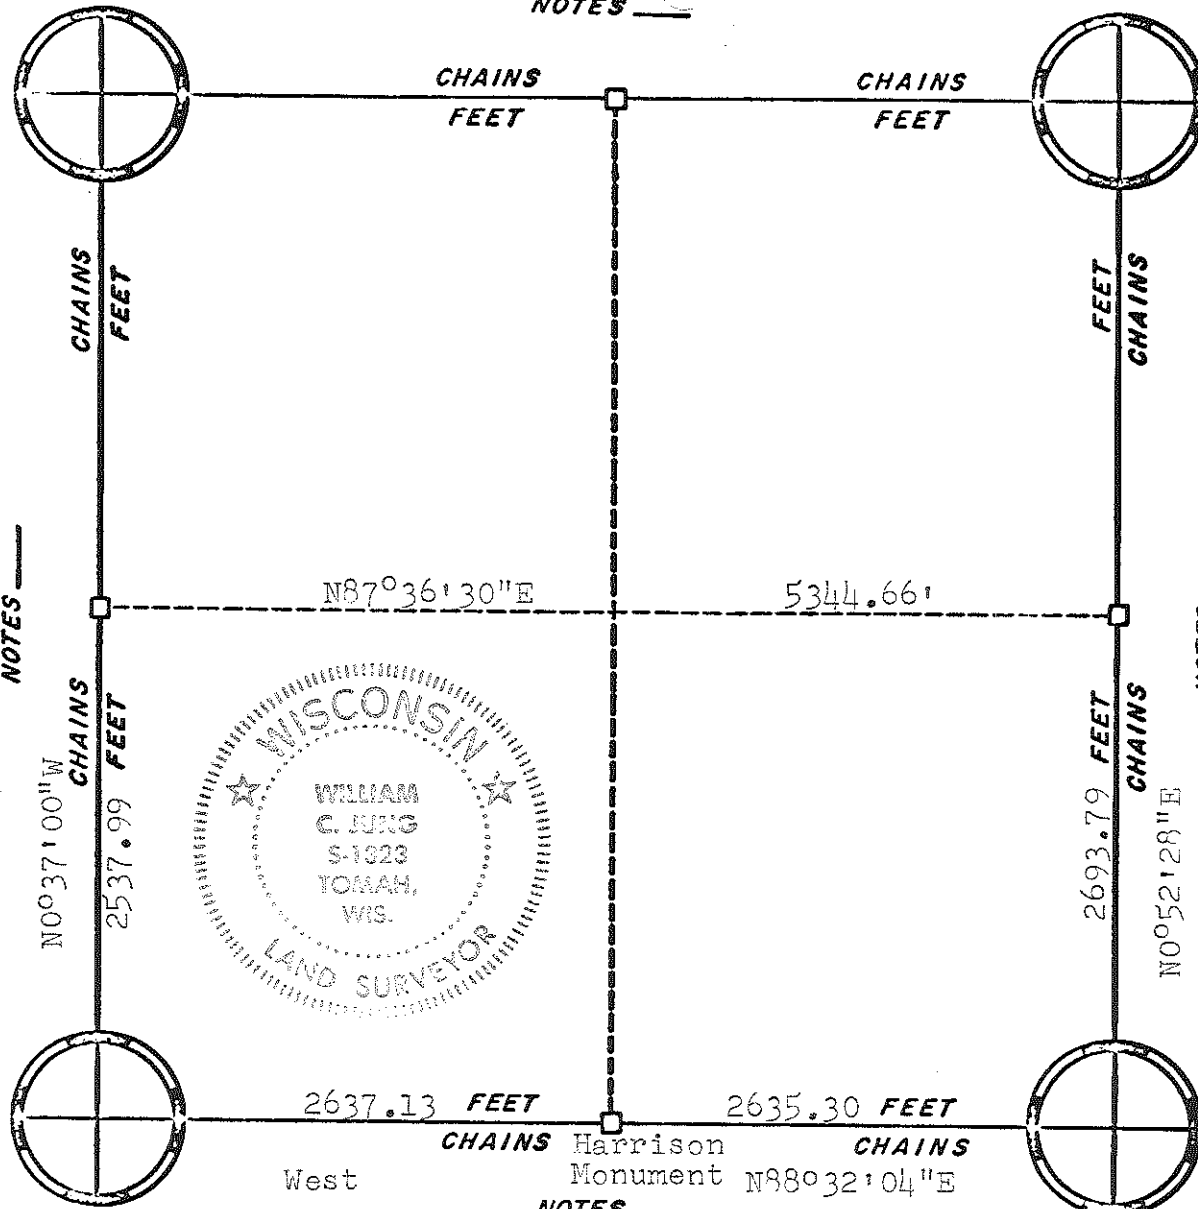

NOTES _____

NOTES _____

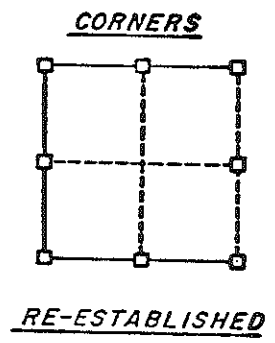


ORIGINAL SURVEY DATA

BY *wcj*

DATE 3/7/79


| | | | | | | |
|---------------------------|----------------------------|-----------------------------|---------------------------------|--------------|-----------------|-------------|
| SURVEYED BY W. C. Jung | CONTRACT DATE June 1975 | COUNTY MONROE [REDACTED] | TOWN-VILLAGE-CITY Ridgeville | SECTION 3 | TOWNSHIP 16N | RANGE 2W |
|---------------------------|----------------------------|-----------------------------|---------------------------------|--------------|-----------------|-------------|

NOTES _____

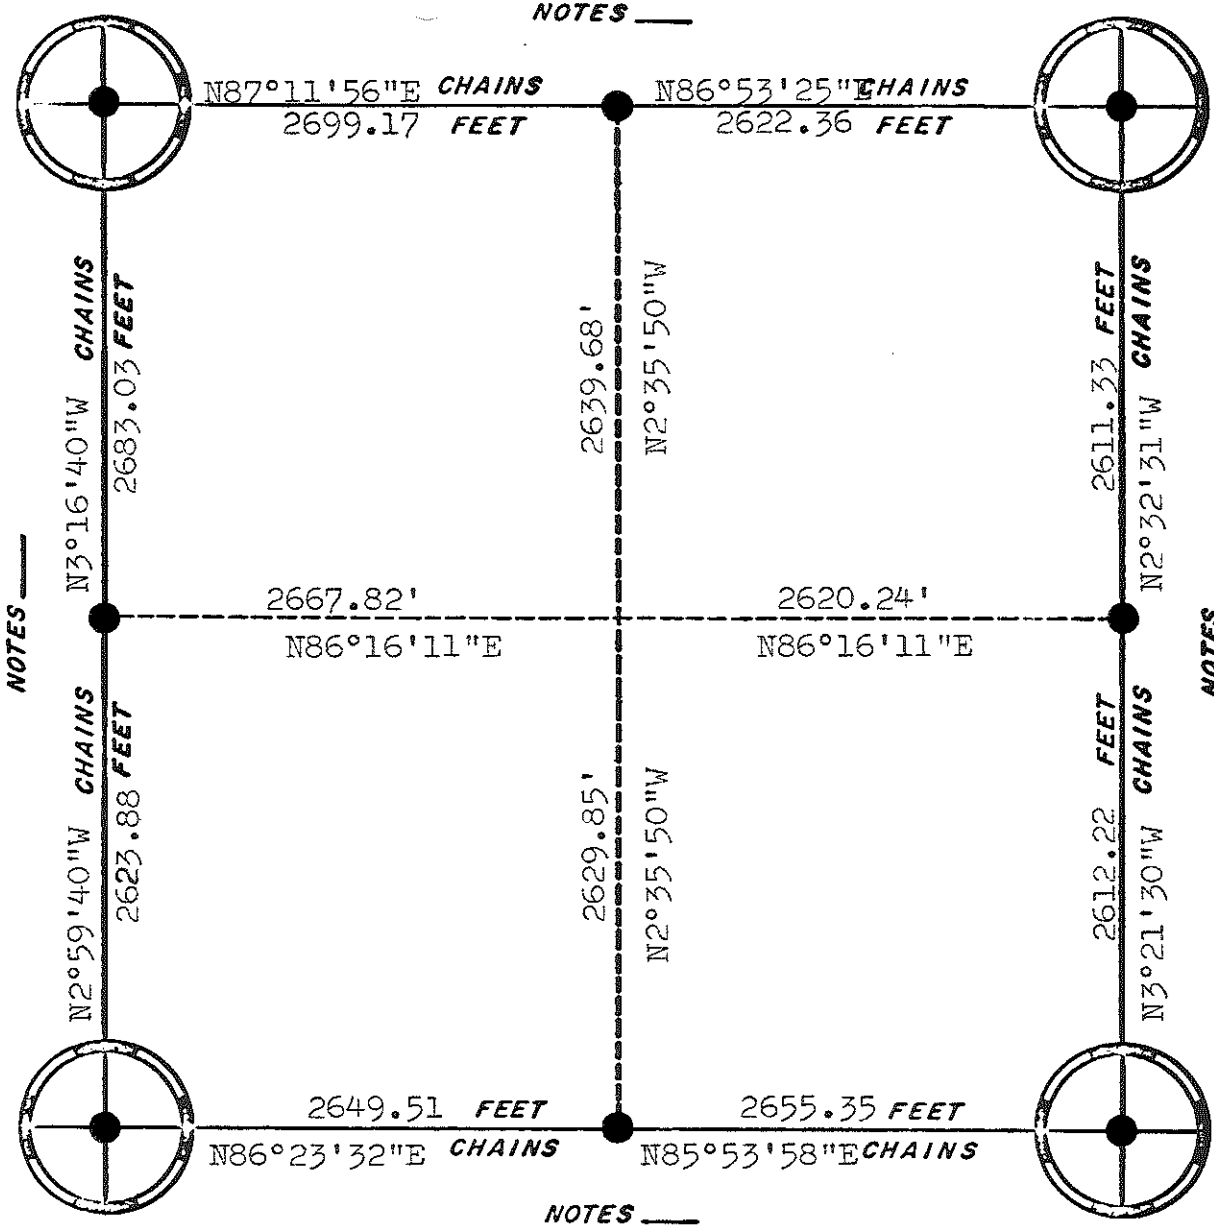

● = Set Harrison Monument

CORNERS

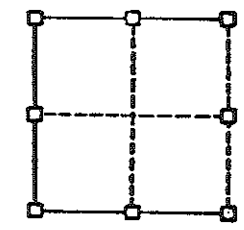

RE-ESTABLISHED

NOTES _____

NOTES _____

NOTES _____

ORIGINAL SURVEY DATA

BY




DATE 1/14/82


| | | | | | | |
|---------------------------|--------------------------------|-----------------------------|---------------------------------|---------------|-----------------|-------------|
| SURVEYED BY Ron Hayden | CONTRACT DATE June 20, 1979 | COUNTY MONROE [REDACTED] | TOWN-VILLAGE-CITY Ridgeville | SECTION 11 | TOWNSHIP 16N | RANGE 2W |
|---------------------------|--------------------------------|-----------------------------|---------------------------------|---------------|-----------------|-------------|

Section 25


T16N, R2W

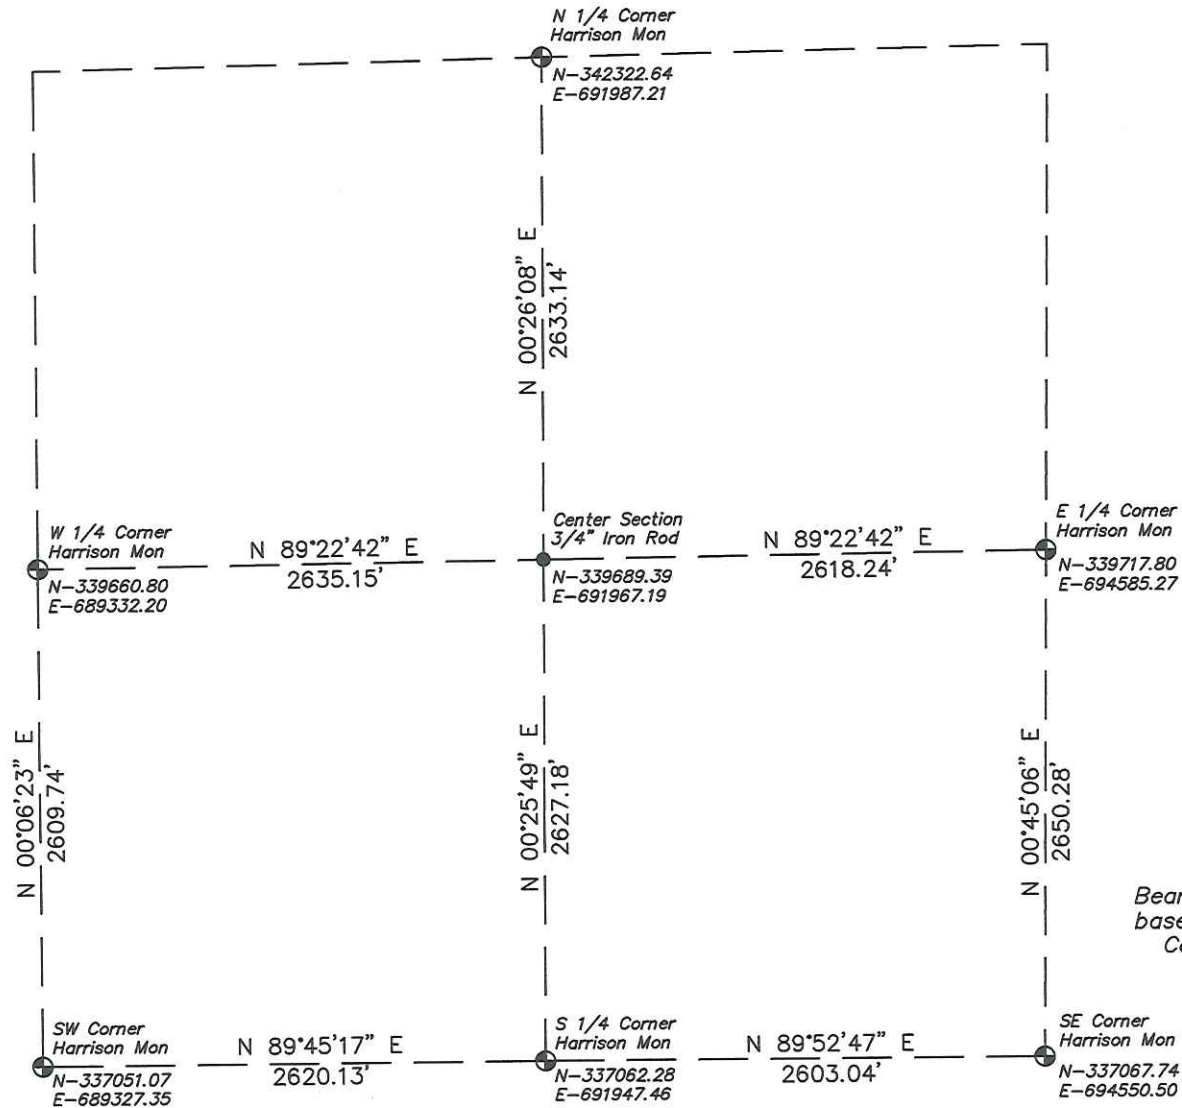

Bearings and Coordinates are based on the Monroe County Coordinate System

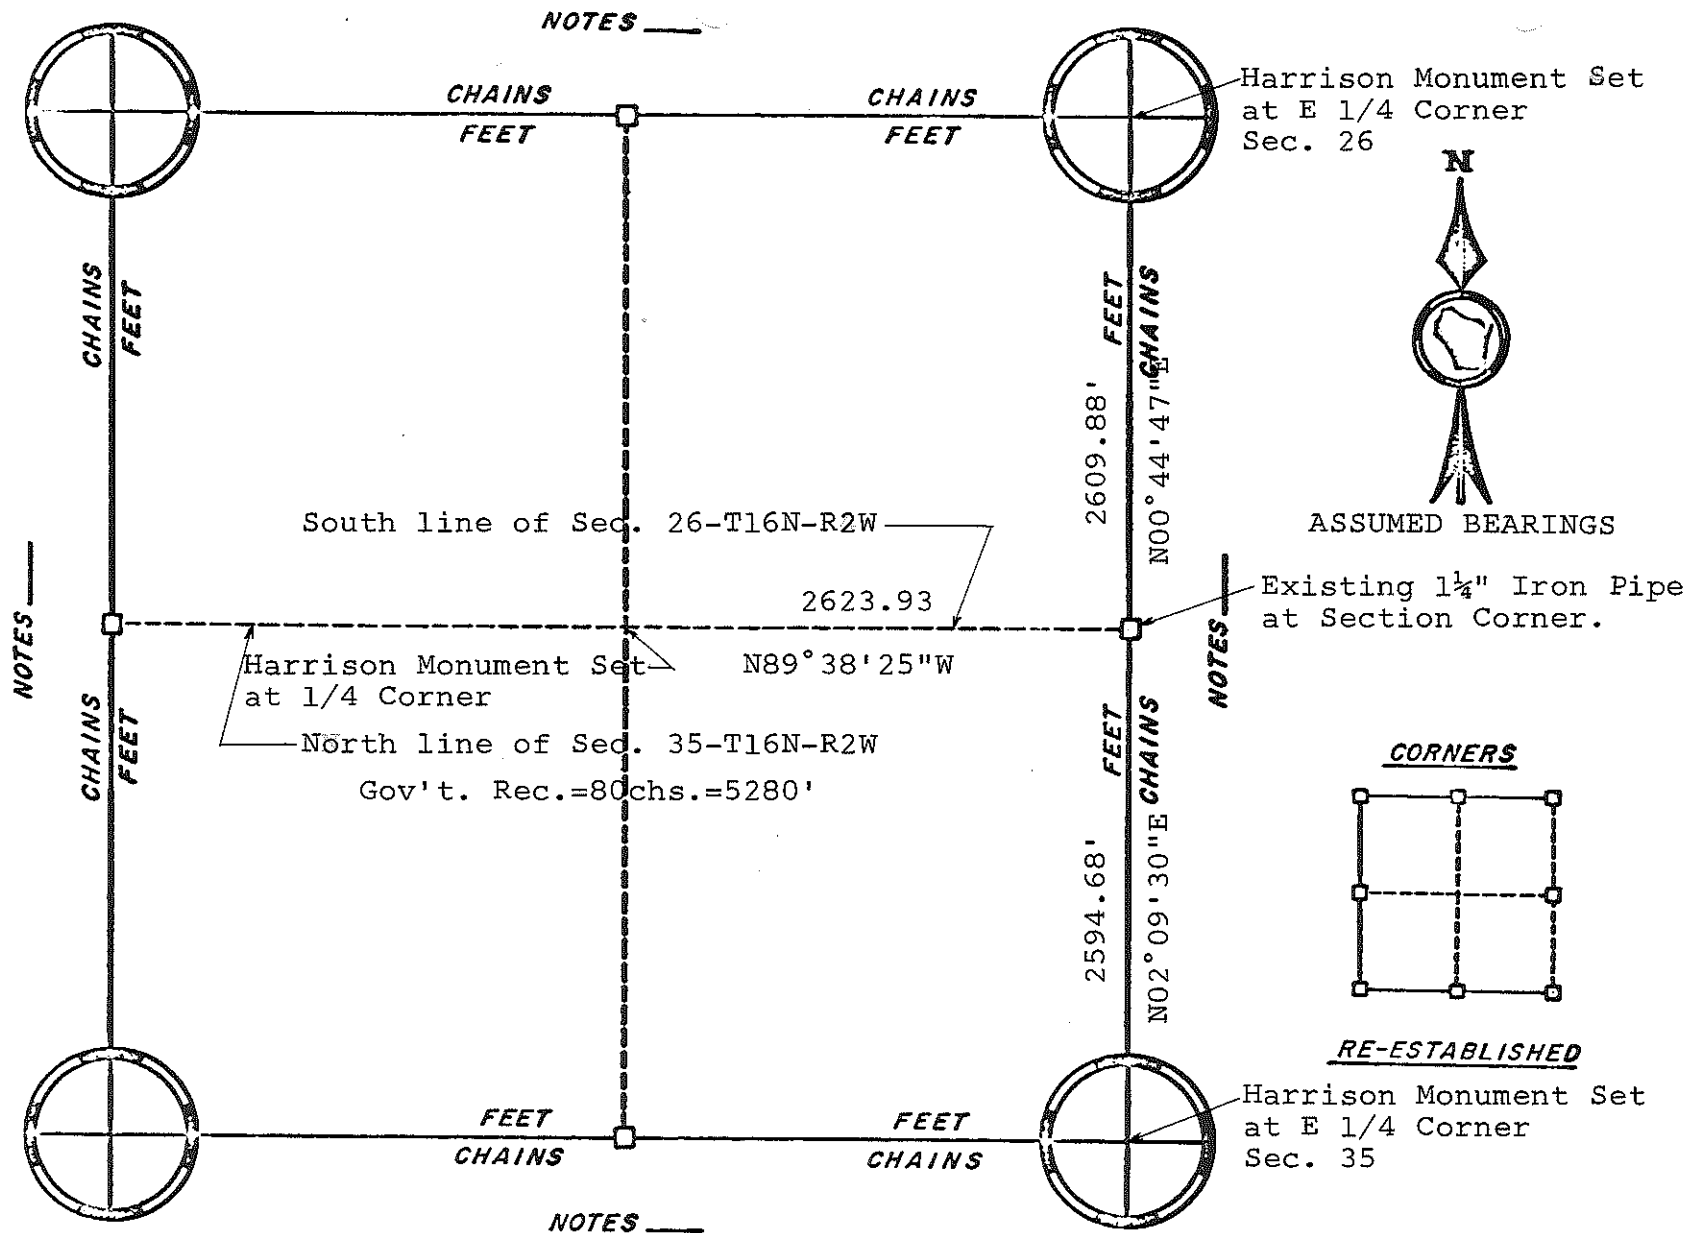

CORNERS

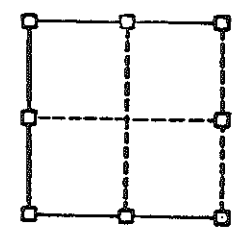

RE-ESTABLISHED


ORIGINAL SURVEY DATA

BY _____
DATE _____

| SURVEYED BY | CONTRACT DATE | COUNTY | MONROE | TOWN-VILLAGE-CITY | SECTION | TOWNSHIP | RANGE |
|----------------------------|---------------|--------|--------|-------------------|---------|----------|-------|
| Feddersen Eng. & Surveying | June, 1980 | | | Ridgeville | 26 & 35 | 16 N | 2 W |

Section Summary and Index

34 - 16 - 2W
 Section Town Range

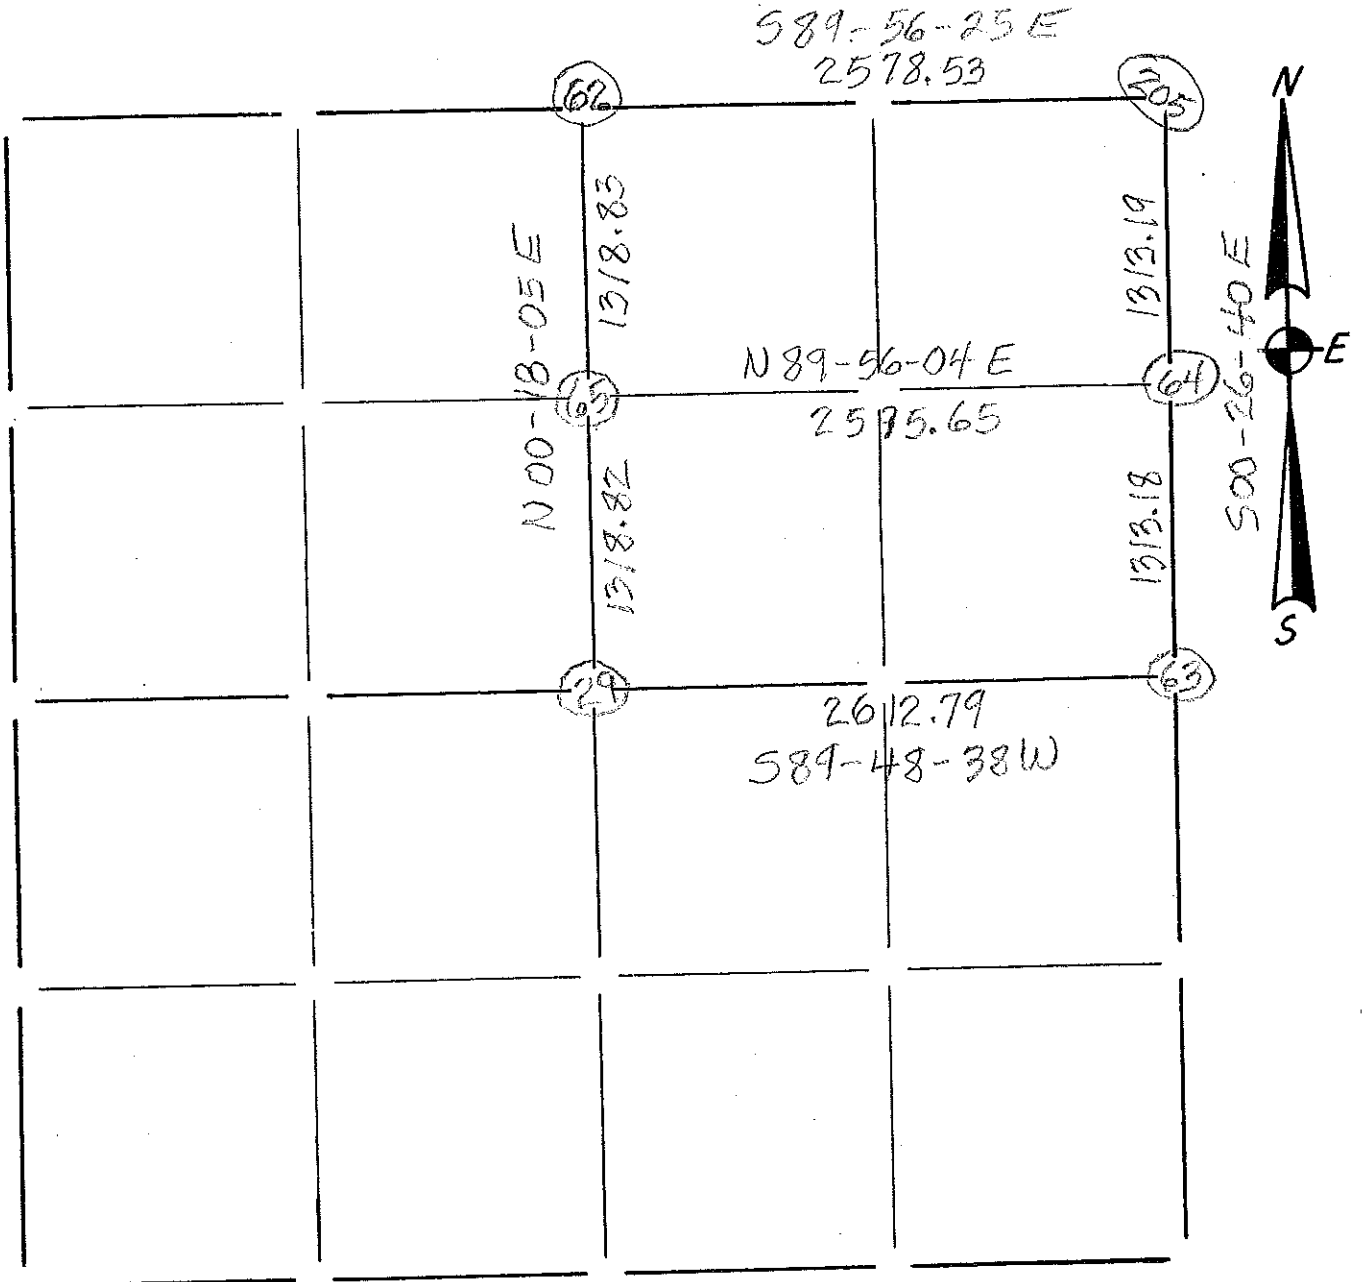

LEGEND

- ⊕ - Harrison cast iron monument.
- - Stone or concrete monument.
- - Other _____



10/23/06

34-16-24

Schreier-Capaw

Occupied POINT

Occupied POINT

Occupied POINT

| | | | |
|---------|-------------|-----------------|------------|
| 62 | 12,631.9052 | 9,161.5611 | 0.0000 |
| INVERSE | | S 89:56'25.4" E | 2,578.5314 |
| 205 | 12,629.2229 | 11,740.0911 | 0.0000 |
| INVERSE | | S 0:26'39.5" E | 2,626.3744 |
| 63 | 10,002.9275 | 11,760.4576 | 0.0000 |
| INVERSE | | S 89:48'38.5" W | 2,612.7872 |
| 29 | 9,994.2946 | 9,147.6847 | 0.0000 |
| INVERSE | | N 0:18'05.1" E | 2,637.6471 |
| 62 | 12,631.9052 | 9,161.5611 | 0.0000 |

Occupied POINT

Occupied POINT

| | | | |
|---------|-------------|----------------|------------|
| 205 | 12,629.2229 | 11,740.0911 | 0.0000 |
| INVERSE | | S 0:26'39.5" E | 1,313.1944 |
| 64 | 11,316.0680 | 11,750.2745 | 0.0000 |
| INVERSE | | S 0:26'39.5" E | 1,313.1800 |
| 63 | 10,002.9275 | 11,760.4576 | 0.0000 |

Occupied POINT

Occupied POINT

| | | | |
|---------|-------------|----------------|------------|
| 62 | 12,631.9052 | 9,161.5611 | 0.0000 |
| INVERSE | | S 0:18'04.8" W | 1,318.8253 |
| 65 | 11,313.0981 | 9,154.6253 | 0.0000 |
| INVERSE | | S 0:18'05.5" W | 1,318.8218 |
| 29 | 9,994.2946 | 9,147.6847 | 0.0000 |

Occupied POINT

Occupied POINT

| | | | |
|---------|-------------|-----------------|------------|
| 65 | 11,313.0981 | 9,154.6253 | 0.0000 |
| INVERSE | | N 89:56'04.0" E | 2,595.6509 |
| 64 | 11,316.0680 | 11,750.2745 | 0.0000 |

Occupied POINT

Occupied POINT



10/23/06

Section 36 T16N, R2W

N 1/4 Corner
Section 35
Harrison Mon
N-337038.15
E-686703.33

N 89°43'04" E
2624.05'

NW Corner
Harrison Mon
N-337051.07
E-689327.35

N 89°45'17" E
2620.13'

N 1/4 Corner
Harrison Mon
N-337062.28
E-691947.46

N 89°52'47" E
2603.04'

NE Corner
Harrison Mon
N-337067.74
E-694550.50



N 01°30'55" E
2594.60'

W 1/4 Corner
1 1/4" Iron Rod
N-334457.38
E-689258.74

S 89°57'44" E
5293.94'

S 00°02'52" E
2613.84'

E 1/4 Corner
Harrison Mon
N-334453.90
E-694552.68

N 00°36'34" W
2675.94'

SW Corner
Harrison Mon
N-331781.59
E-689287.21



Bearings and Coordinates are
based on the Monroe County
Coordinate System