


# U.S. PUBLIC LAND SURVEY MONUMENT RECORD

### INSTRUCTIONS:

This record shall show the location of the corner and shall include all of the following nine elements (a through i).

- (a) Identify the corner by reference to the U.S. public land survey system.  
O = Corner monument restored.

E'1/4 COR  
SEC 30-16-2 W

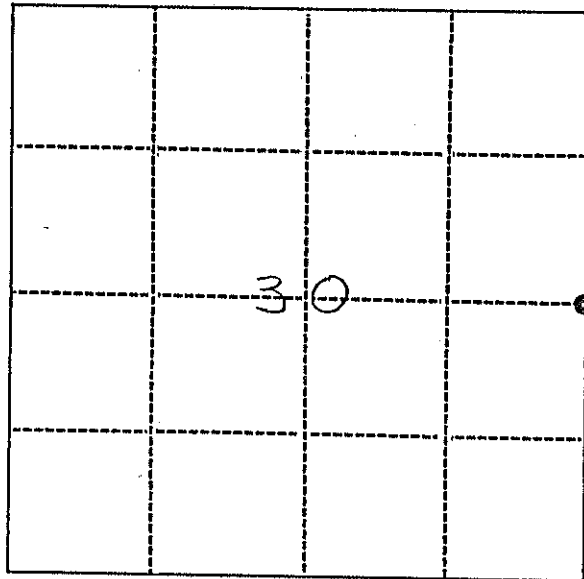

- (b) Describe any record evidence, monument evidence, occupational evidence, testimonial evidence or any other material evidence you considered, and whether the monument was found or placed.  
TRAVERSED FROM SE COR SEC 30 (FENCE CORNER POST) TO THE NE COR SEC 30. SET E'1/4 COR ON LINE AND MID WAY BETWEEN SECTION CORNERS. FOUND WHITE OAK STUMP N63W 27.2 LKS, ALSO FOUND A STUMP AT S10E 14 LKS. COULD NOT IDENTIFY THIS TREE AS WHITE OAK BUT FIT BEARING TREE LOCATION EXCELLENT, THIS THE SAME TYPE OF TREE LISTED AS BUR OAK SW FOR N'1/4 COR SEC 28-16-2W. POSSIBLE MIS-IDENTIFICATION. ALSO FELL VERY CLOSE TO OLD FENCE.
- (c) In the plan view drawing below, provide reference ties to at least 4 witness monuments, or if the location is within a municipality, to at least 2 witness monuments. (Witness monuments shall be made of concrete, natural stone, iron or other equally durable material.)  
Describe witness monuments.

- (d) Show a plan view drawing depicting the relevant monuments and reference ties which is sufficient in detail to enable accurate relocation of the corner monument if the corner monument is disturbed. Indicate north.

