

U.S. Land Survey Monument Record

Corner ID: E1/4 31, T16N-R2W

21602312000

Type of Monument:

Set mag nail

County Coordinates:

334402.1
668249.5

Witnesses: Zachariah P. Dechant
Gary L. Dechant

Basis For Monument Location:

(Show info such as history, evidence, testimony, found or method of relocation)


Gary Sime shows an existing 1/4" iron bar at this corner in Vol 22 CSM P65 in 2007.

Paul Fairchild shows found county monument in a road survey of CTH "U" in 2009.

The origin of the 1/4" iron bar is not certain.

The monument must have been destroyed during the road construction of 2009 as we could find no marker.

We reset the corner using the information from both aforementioned surveys. Set mag nail. Falls 1' south of traveled centerline of CTH "U". It falls in line with what remains of occupied fence to the south.

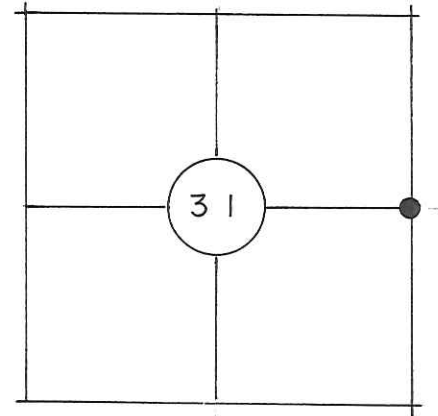

- = Existing 1/4" iron bar and survey sign
- ⦿ = Set 1"x24" iron pipe, down 12"
- ⊙ = Set 1/2"x12" iron rod, down 12"
- = Set 1/4"x24" iron pipe, down 10"

Gary L. Dechant

July 31, 2013

