

CERTIFICATE

CERTIFIED LAND CORNER

No. 87

21602210000

I, Harley A. Sime, do hereby certify that on the 6th day of November 1974, I found (evidence) (~~no evidence~~) of the SW corner of Section 22, T 16 N, R 2 W Fourth Principal Meridian, and I re-established said corner according to the Wisconsin Statutes as shown and described hereon.

History of original corner establishment:

A.S. Ingalls was at this corner in May of 1873. Fred Holden was at this corner in June of 1904. Holden shows an iron stake at this corner in May of 1907.

Description of corner evidence found:

Dated this 7th day of Feb. 1978.

Reset a 3/4" iron bar with a Harrison Monument, flush with ground.

County Surveyor
Title



Approved: HARLEY A. SIME
MONROE CO. SURVEYOR

COUNTY SURVEYOR FORM NO. 1

Description of corner and witness monuments, references and accessories used to perpetuate the original or re-established location of this corner:

Witnesses to corner location:

D. Marten

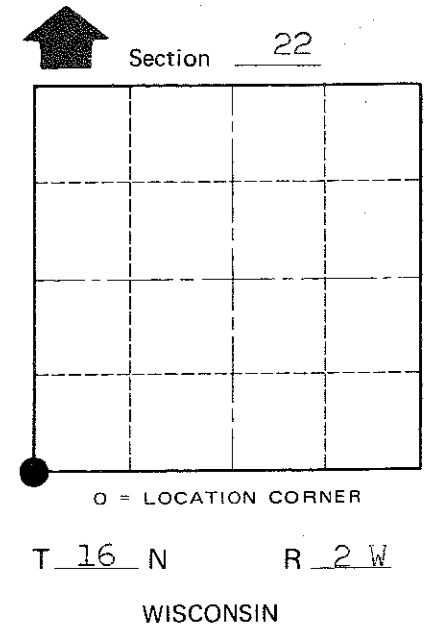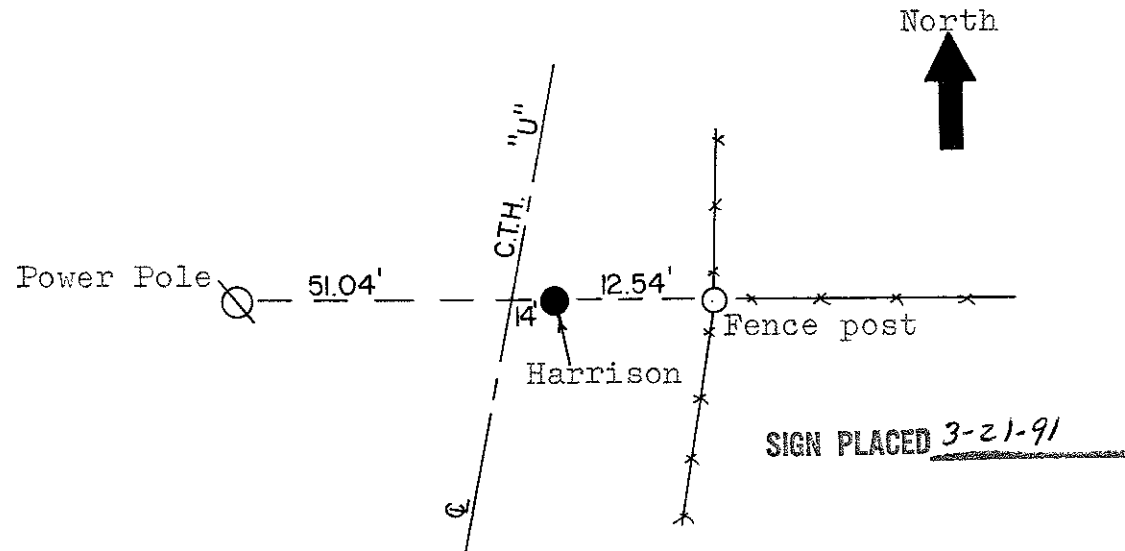

SURVEY CONTROL ORDER

Horizontal	_____
Vertical	_____

WISCONSIN COORDINATE SYSTEM

Corner	East (X)	North (Y)	Elevation (Z)	Zone
Control Sta. Name				

City, Village or Town Ridgeville

County of Monroe