

CERTIFICATE

CERTIFIED LAND CORNER

No. 77

**21602212000**

I, Harley A. Sime, do hereby certify that on the 6<sup>th</sup> day of November 1981, I found (evidence) (~~no evidence~~) of the West 1/4 corner of Section 22, T 16 N, R 2 W Fourth Principal Meridian, and I re-established said corner according to the Wisconsin Statutes as shown and described hereon.

History of corner establishment since Original Government Survey

A.S. Ingalls was here in May of 1873  
D. Marten was here in Nov. of 1974 and set an iron bar.

Dated this 10<sup>th</sup> day of Nov. 1981.  
Harley A. Sime R.L.S. 355

Description of corner evidence found:

Found Marten's iron bar and replaced it with a Harrison monument.

County Surveyor

Approved: <sup>Title</sup> **HARLEY A. SIME**


**MONROE CO. SURVEYOR**

Description of corner and witness monuments, references and accessories used to perpetuate the original or re-established location of this corner:


Witnesses to corner location:

B. Meyer

C. Pietz

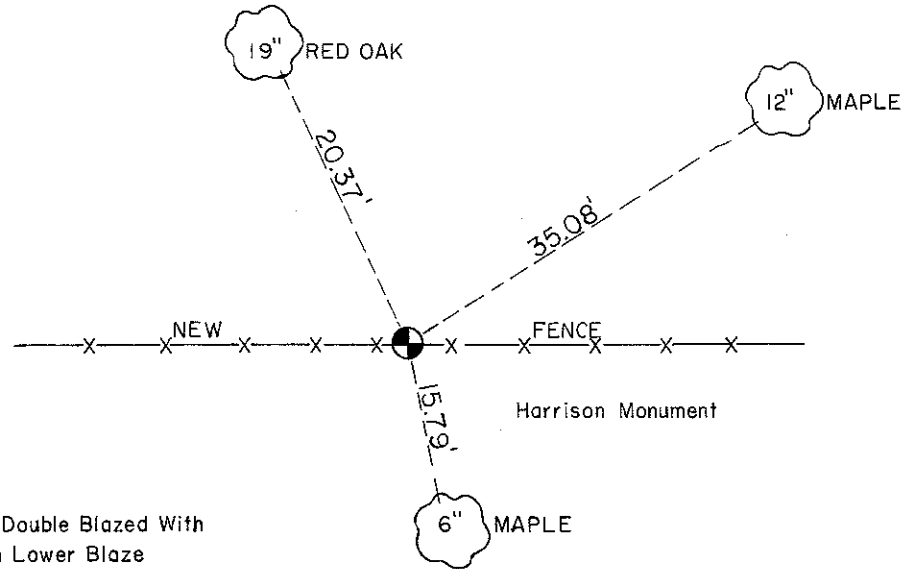

Trees Double Blazed With Nail In Lower Blaze

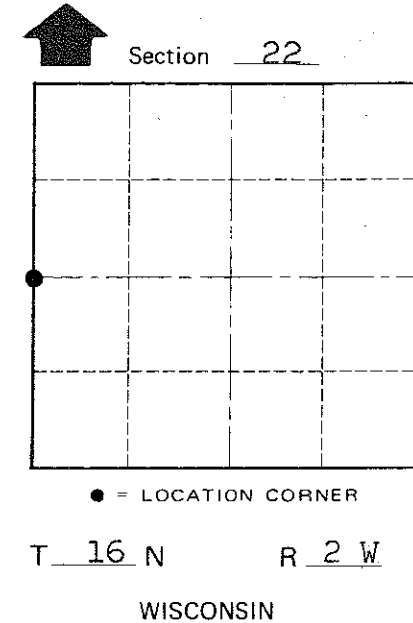

COUNTY SURVEYOR FORM NO. 1

SURVEY CONTROL ORDER

Horizontal	_____
Vertical	_____

WISCONSIN COORDINATE SYSTEM

Corner	East (X)	North (Y)	Elevation (Z)	Zone
Control Sta. Name				

~~City/Village~~ Town Ridgeville  
County of Monroe  
Wisconsin