

CERTIFICATE

CERTIFIED LAND CORNER

No. 78

2160222000

I, Harley A. Sime, do hereby certify that on the 8th day of November 1974 I found (evidence) (~~no evidence~~) of the E 1/4 corner of Section 22, T 16 N, R 2 W, Fourth Principal Meridian, and I re-established said corner according to the Wisconsin Statutes as shown and described hereon.

History of original corner establishment:

A.S. Ingalls was at this corner in May of 1873.

Description of corner evidence found:

Accepted fence corner as best available evidence. Set Harrison Monument, up 2".

Dated this 7th day of Feb. 1978.



County Surveyor _____
Title

Approved: HARLEY A. SIME
MONROE CO. SURVEYOR

Description of corner and witness monuments, references and accessories used to perpetuate the original or re-established location of this corner:

Witnesses to corner location:

D. Marten

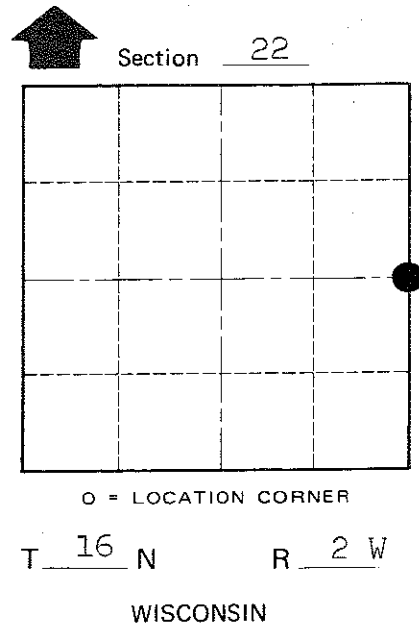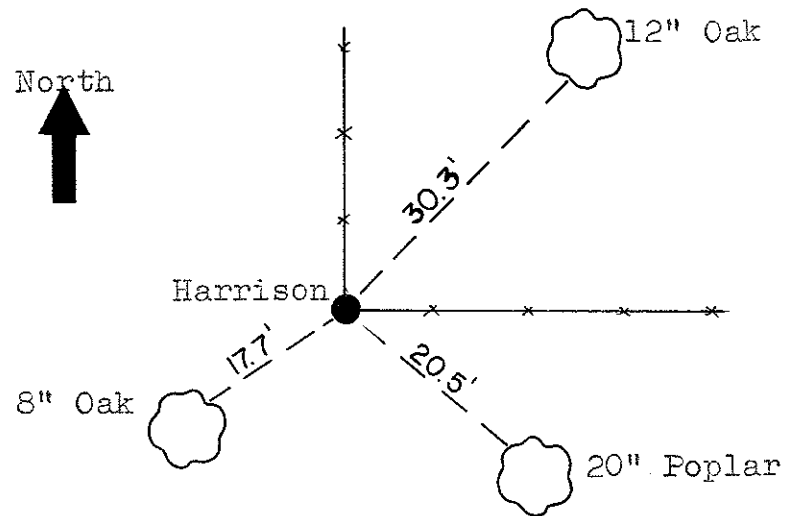

SIGN PLACED 5-22-92

COUNTY SURVEYOR FORM NO. 1

SURVEY CONTROL ORDER

| | |
|------------|-------|
| Horizontal | _____ |
| Vertical | _____ |

WISCONSIN COORDINATE SYSTEM

| Corner | East (X) | North (Y) | Elevation (Z) | Zone |
|-------------------|----------|-----------|---------------|------|
| Control Sta. Name | | | | |

City, Village or Town Ridgeville
County of Monroe