(evidence) (no evidence) of the SE corner of Section 15, T\_16\_N. R 2 W Fourth Principal Meridian, and I re-

established said corner according to the Wisconsin

Dated this 7th day of Feb. 1978.

\_\_\_\_19\_74\_. I found

No.	65
21602	150000

History of original corner establishment:

A.S.Ingalls was at this corner in May of 1873.

Description of corner evidence found:

Reset an existing 3/4" iron bar with a Harrison Monument, down 2" below ground surface.

County Surveyor

FORM

Statutes as shown and described hereon.


I. Harley A. Sime certify that on the \_\_\_\_\_


Nov.

Approved: HARLEY A. SIME MONROE CO. SURVEYOR

Description of corner and witness monuments, references and accessories used to perpetuate the original or re-established location of this corner:

Witnesses to corner location:	
D. Marten	
	t"

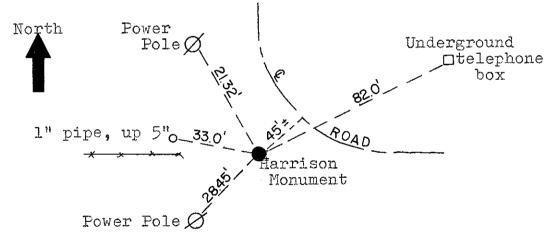

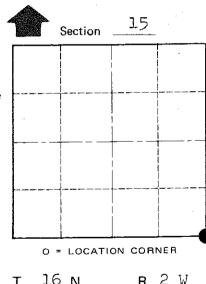

T\_ 16 N

R 2 W

WISCONSIN

SURVEY CONTROL ORDER

lorizontal		WISCONSIN CO	OORDINATE SYSTEM	
/ertical	East (X)	North (Y)	Elevation (Z)	Zone
Corner	Last (A)	(toral (1)		
Control Sta. Name				

city, Village or Town	Ridgeville
County of	Monroe