

21602090000

I, Harley A. Sime, do hereby certify that on the 30th day of June 1975, I found (evidence) (~~no evidence~~) of the Southwest corner of Section 10, T 16 N, R 2 W, Fourth Principal Meridian, and I re-established said corner according to the Wisconsin Statutes as shown and described hereon.

History of original corner establishment:

**Approved: HARLEY A. SIME  
MONROE CO. SURVEYOR**

Description of corner evidence found:

Dated this 4th day of March 1976.

Found a 3/4"x24" iron bar set by D. Marten in 1974. Removed the iron bar and replaced it with a Harrison marker. Marten set the bar during the survey for the "Tri-Creek Watershed Project". It appears Marten accepted the old fence corner as the best available evidence.

County Surveyor  
Title

Description of corner and witness monuments, references and accessories used to perpetuate the original or re-established location of this corner:



**Set a Harrison at the fence corner and piled rocks around it.**

Witnesses to corner location:

W.C. Jung-Crew Chief *W.C. Jung*

A. Lueck

G. Dechant

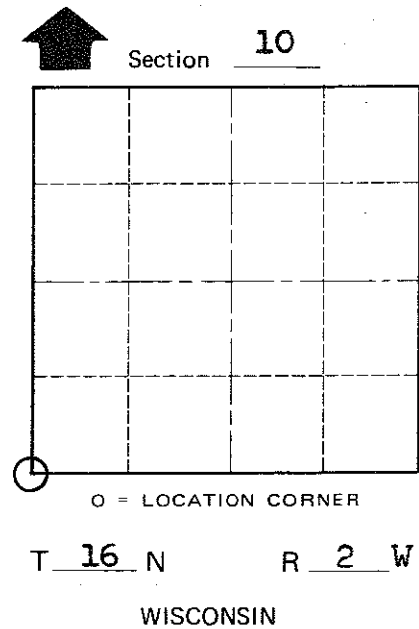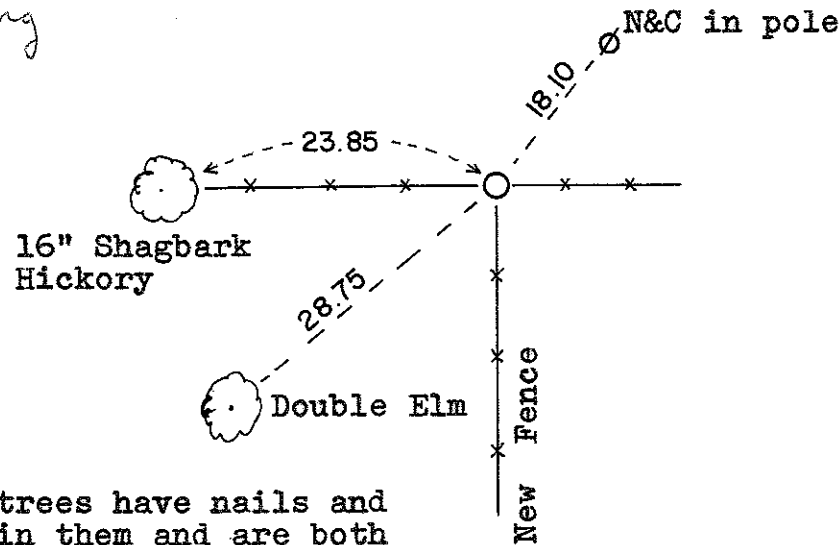

COUNTY SURVEYOR FORM NO. 1

SURVEY CONTROL ORDER

Horizontal	_____
Vertical	_____

(Both trees have nails and caps in them and are both blazed.)

WISCONSIN COORDINATE SYSTEM

Corner	East (X)	North (Y)	Elevation (Z)	Zone
Control Sta. Name				

City, Village or Town Ridgeville  
County of Monroe