

CERTIFICATE

CERTIFIED LAND CORNER

No. 37

21602092000

I, Garold A. Sime, do hereby certify that on the 3rd day of November 1981 I found ~~(no evidence)~~ (no evidence) of the W<sup>1</sup>/<sub>4</sub> corner of Section 10, T 16 N, R 2 W Fourth Principal Meridian, and I re-established said corner according to the Wisconsin Statutes as shown and described hereon.

History of corner establishment since Original Government Survey  
No known recorded history since the original government survey.

Dated this 23rd day of Nov. 1981.  
Garold A. Sime, R.L.S. 1261

Description of corner evidence found:

I set this corner equidistant and on line between the NW and SW corners of Section 10. This fits the existing conditions well.


County Surveyor's Office  
Title

*Garold A. Sime*

Description of corner and witness monuments, references and accessories used to perpetuate the original or re-established location of this corner:

Witnesses to corner location:

C. Pietz

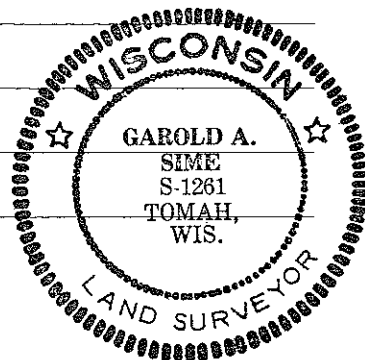

7" MAPLE, DOUBLE BLAZED WITH NAIL SET IN TOP BLAZE

53.31'

ROAD  
TOWN


SIGN PLACED 12/23/86  
*Kenworthy*

SET HARRISON MONUMENT, DOWN 3" ±

5' ±

24.73'

SET 1 1/4" SQUARE IRON BAR 23" LONG, UP 2" ±, 1' SOUTH OF OLD BRACE POST.

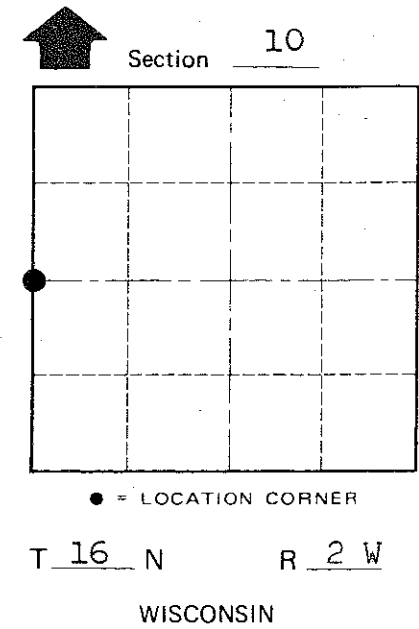

Approved: **HARLEY A. SIME**  
**MONROE CO. SURVEYOR**

SURVEY CONTROL ORDER

Horizontal	_____
Vertical	_____

WISCONSIN COORDINATE SYSTEM

Corner	East (X)	North (Y)	Elevation (Z)	Zone
Control Sta. Name				

~~City, Village or~~ Town Ridgeville  
County of Monroe

COUNTY SURVEYOR FORM NO. 1