

21603040000

I, William C. Jung, do hereby certify that on the 1st day of May 19 81, I found (evidence) ~~none~~ of the Northwest corner of Section 10, T 16 N, R 3 W Fourth Principal Meridian, and I re-established said corner according to the Wisconsin Statutes as shown and described hereon.

Dated this 14th day of Aug. 19 81.

William C. Jung

Registered Land Surveyor

Title

William C. Jung

History of corner establishment since Original Government Survey

None recorded since the original government survey.

Description of corner evidence found: To the Northwest I found what I believe to be an original Bearing Tree. The old stump was very rotted and easily broke apart. It was hard to judge its size considering its condition, but it was smaller than expected. However, considering the steep slope and sandy stoney ground, one can assume that an oak in this location would grow slower than normal. Set as such, this corner fits the road for alignment to the South and fits the original distance to the South to the 1/4 corner (meas. = 2638.41, Rec. = 2640). The existing line fence to the East at the W1/16NW corner splits this 1/2 mile distance perfectly. This corner also fits the original distance for two miles to the East (meas. = 10532.03 Rec. = 10525.68).



Description of corner and witness monuments, references and accessories used to perpetuate the original or re-established location of this corner:

Trees Double Blazed With Nail In Lower Blaze

Witnesses to corner location:


William C. Jung

Carlton R. Pietz

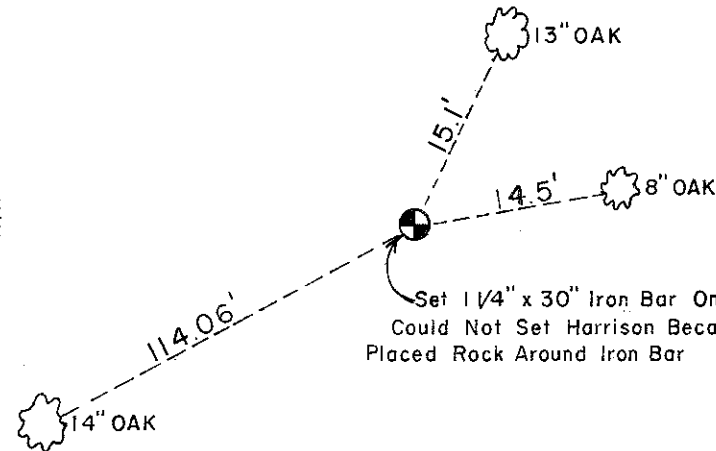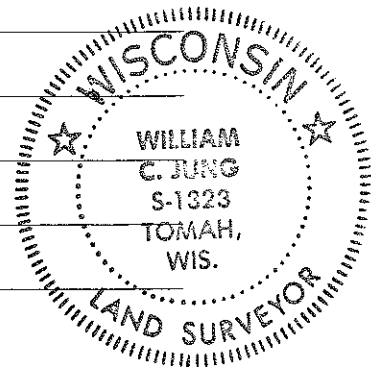

Set 1/4" x 30" Iron Bar On Steep Slope
Could Not Set Harrison Because Of Rock
Placed Rock Around Iron Bar

SIGN PLACED 1-18-95 *J. Sime*

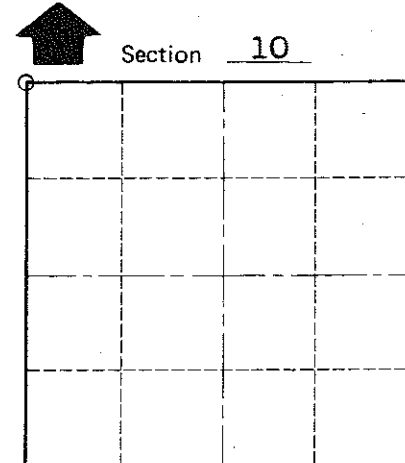

O = LOCATION CORNER

T 16 N R 3 W

WISCONSIN

Approved: **HARLEY A. SIME**
MONROE CO. SURVEYOR

SURVEY CONTROL ORDER

Horizontal	_____
Vertical	_____

WISCONSIN COORDINATE SYSTEM

Corner	East (X)	North (Y)	Elevation (Z)	Zone
Control Sta. Name				

~~City, Village or~~ Town Wells
County of Monroe
Wisconsin

COUNTY SURVEYOR FORM NO. 1