

21603072000

I, Lawrence A. Feddersen, do hereby certify that on the 22 day of September 1981, I found ~~XXXXXX~~ (no evidence) of the E 1/4 corner of Section 7, T 16 N, R 3W Fourth Principal Meridian, and I re-established said corner according to the Wisconsin Statutes as shown and described hereon.

Dated this 30 day of Nov. 1981.

Lawrence A. Feddersen

Registered Land Surveyor Title

History of corner establishment since Original Government Survey

None

Description of corner evidence found:

Set Harrison at what I believe to be the intersection of fences. The corner is 15.41 feet North of half way and 15.26 feet West of a straight line between the NE corner and the SE corner.



Description of corner and witness monuments, references and accessories used to perpetuate the original or re-established location of this corner:

Witnesses to corner location:

Lawrence A. Feddersen

Thomas Mangene

Approved: HARLEY A. SIME MONROE CO. SURVEYOR

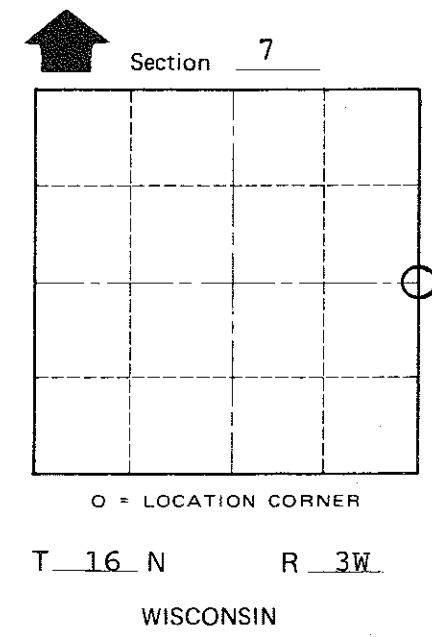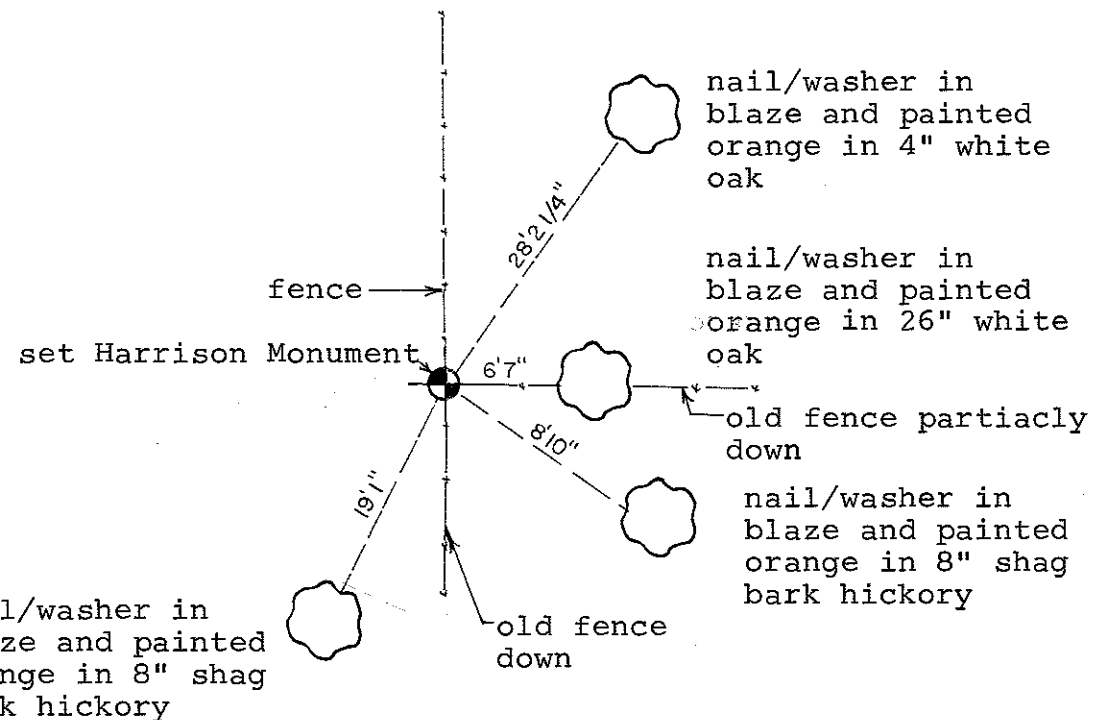

COUNTY SURVEYOR FORM NO. 1

SURVEY CONTROL ORDER

Horizontal _____ Vertical _____

WISCONSIN COORDINATE SYSTEM

Table with columns: Corner, Control Sta. Name, East (X), North (Y), Elevation (Z), Zone

XXXXXXX Town of Wells County of Monroe