

**21603160020**

I, Gary L. Dechant, do hereby certify that on the 14th day of November 1997, I found ~~(evidence)~~ (no evidence) of the S<sup>1</sup>/<sub>4</sub> corner of Section 16, T16 N, R 3 W Fourth Principal Meridian, and I re-established said corner according to the Wisconsin Statutes as shown and described hereon.

Dated this 18th day of Nov. 1997.

Gary L. Dechant  
Registered land surveyor 1744  
Title

History of corner establishment since Original Government Survey

Fred A. Holden and Hamilton LaRue were both here in 1898.  
Ron Parish set a Harrison Monument here in August of 1987.

Description of corner evidence found:

Found Parish's Harrison, but it did not fit his recorded distances between section corners. After talking with Ron, we agreed that I would move the Harrison to fit his computed point, set on line between section corners.




Parish measurements SW Corner S89°08'40"W, 2640.68' S<sup>1</sup>/<sub>4</sub> Corner S89°08'40"W, 2670.68' SE Cor.  
My prorated measurements N89°08'50"E, 2641.05' N89°08'50"E, 2671.06'

This corner fits the remains of the occupied NW corner of the NE<sup>1</sup>/<sub>4</sub>-NW<sup>1</sup>/<sub>4</sub> of Sec. 21 very well.

Description of corner and witness monuments, references and accessories used to perpetuate the original or re-established location of this corner:

Witnesses to corner location:

David E. Madison  
Gary L. Dechant

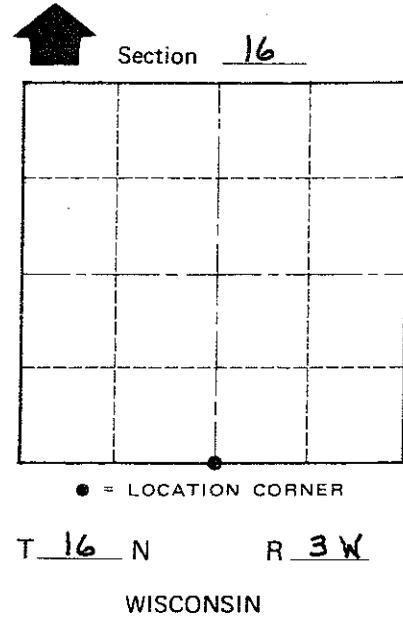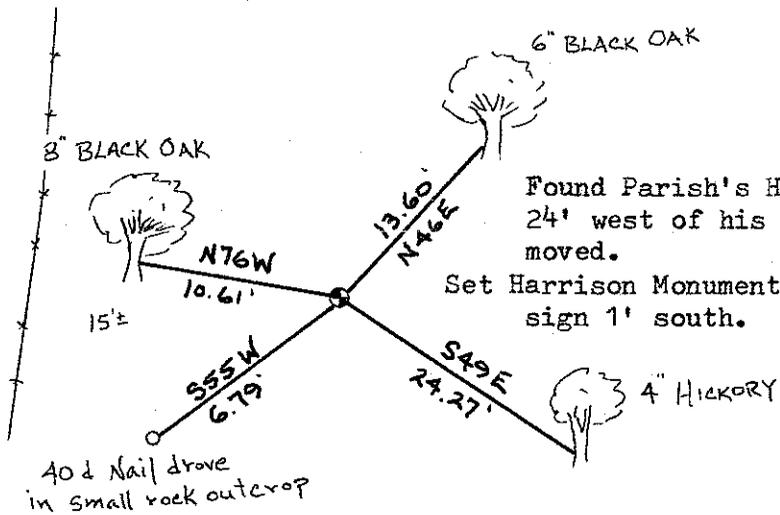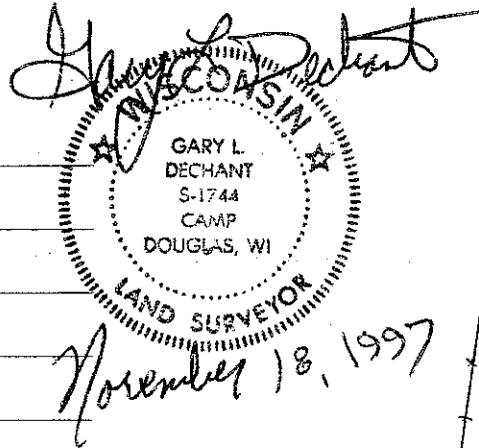

(Trees double blazed with 40d nails set)

SURVEY CONTROL ORDER

Horizontal \_\_\_\_\_  
Vertical \_\_\_\_\_

WISCONSIN COORDINATE SYSTEM

Corner	East (X)	North (Y)	Elevation (Z)	Zone
Control Sta. Name				

City, Village or Town WELLS

County of MONROE

I, Ronald D. Parish, do hereby certify that on the 31st day of August 19 87, I found (evidence) (no evidence) of the S 1/4 corner of Section 16, T16 N, R 3 W. Fourth Principal Meridian, and I re-established said corner according to the Wisconsin Statutes as shown and described hereon.

Dated this 18th day of Sept. 1987.

Ronald D. Parish  
Registered Land Surveyor  
Title

History of corner establishment since Original Government Survey

No known history since the Original Government Survey

Description of corner evidence found:

Found traces of an old fence line north and south. Set corner at old fence line and a straight line between the SE corner and the SW corner. This fits the recorded distance to the east reasonably well, but is short to the west.

COUNTY SURVEYOR FORM NO. 1


Description of corner and witness monuments, references and accessories used to perpetuate the original or re-established location of this corner:

Witnesses to corner location:


Ronald Parish  
Robert Sherwood



All trees double blazed with nail and tab in one blaze.

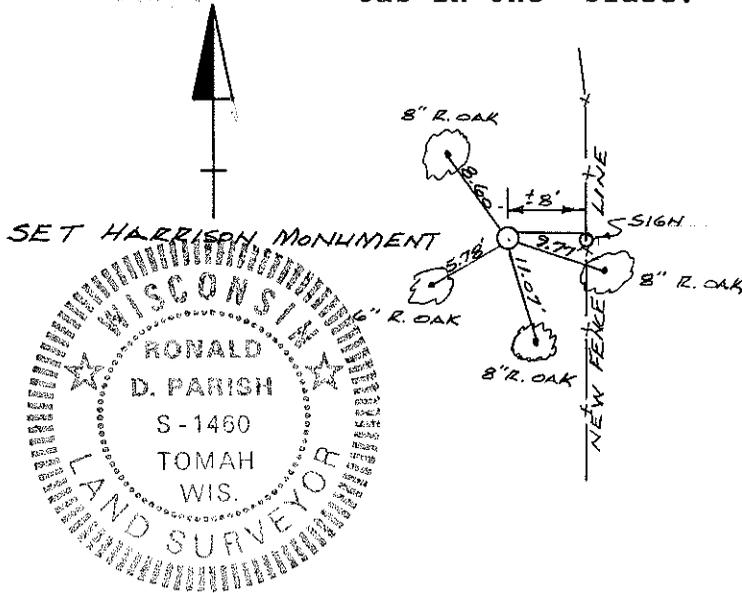

*See New Tie Sheet Dated 11/18-97*

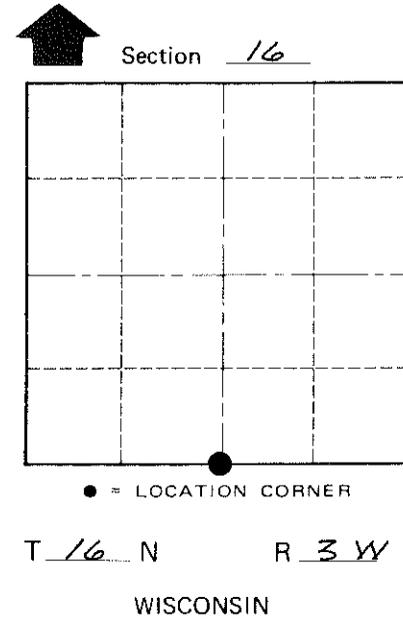

SURVEY CONTROL ORDER

Horizontal \_\_\_\_\_  
Vertical \_\_\_\_\_

WISCONSIN COORDINATE SYSTEM

Corner	East (X)	North (Y)	Elevation (Z)	Zone
Control Sta. Name				

City, Village or Town Wells  
County of Monroe