

**U.S. PUBLIC LAND CORNER
MAINTENANCE**

131

**Corner ID: SW Sec.32, T16N-R3W
21603310000**

<u>DATE</u>	<u>CREW</u>	<u>MONUMENT INFO</u>
March 24, 2020	Al Hoff Gary L. Dechant	Existing Harrison, top broke off, all fencing gone, now in tillable field

	<u>Bearing</u>	<u>Distance</u>
1) Reset disturbed 11/16" in field, set down 10"	N89°42'19"W	26.31' (25.95')
2) Reset disturbed 1/4" iron pipe in field, set down 10"	N89°53'24"E	27.77' (27.95')
3) Set 3/4"x24" round iron bar in field, down 10"	S31°24'42"E	23.67'
4) Reset disturbed 11/16" round iron bar in field, set down 10"	S89°59'34"E	59.77' (59.60')
5) Set 3/4"x24" round iron bar in field, down 10"	N19°32'36"W	30.85'

Gary L. Dechant
WISCONSIN
GARY L.
DECHANT
S-1744
DOUGLAS, WI
LAND SURVEYOR
March 31, 2020

I, Garold A. Sime, do hereby certify that on the 8th day of June 1984, I found ~~evidence~~ (no evidence) of the SW corner of Section 32, T16 N, R3 W. Fourth Principal Meridian, and I re-established said corner according to the Wisconsin Statutes as shown and described hereon.
 Dated this 28th day of Sept. 1984.

Garold A. Sime
Garold A. Sime, R.L.S. 1261
Title

History of corner establishment since Original Government Survey

Fred Holden was here in April of 1903 and had a sleigh shoe at corner, he was also here in Sept. of 1910
 H. A. Sime was at this corner in Aug. 1961.
 D. Malliet was near this corner in Oct. of 1976

Description of corner evidence found:

I set this corner on line with the West line of the NW $\frac{1}{4}$ of Sec.32 projected south to intersect the existing fence line along the south line of the SE $\frac{1}{4}$ -SE $\frac{1}{4}$, Sec.31. This location landed very close to the existing iron pipe(leaning) set by H.A. Sime.

Description of corner and witness monuments, references and accessories used to perpetuate the original or re-established location of this corner:

Set Harrison Monument

Witnesses to corner location:

G.A. Sime
Dallas Wilhite





SURVEY CONTROL ORDER

Horizontal	_____
Vertical	_____

WISCONSIN COORDINATE SYSTEM

Corner	East (X)	North (Y)	Elevation (Z)	Zone
Control Sta. Name				

See Reverse Side For Maintenance

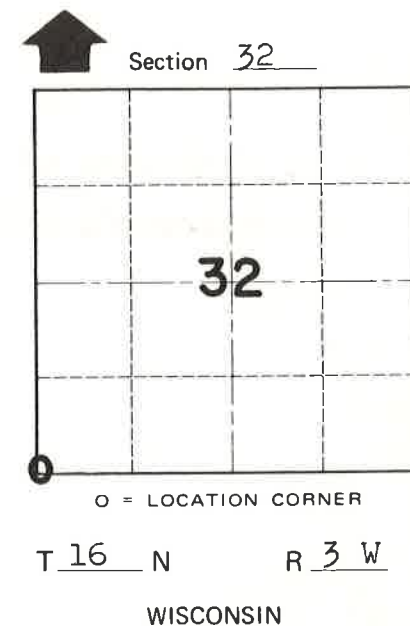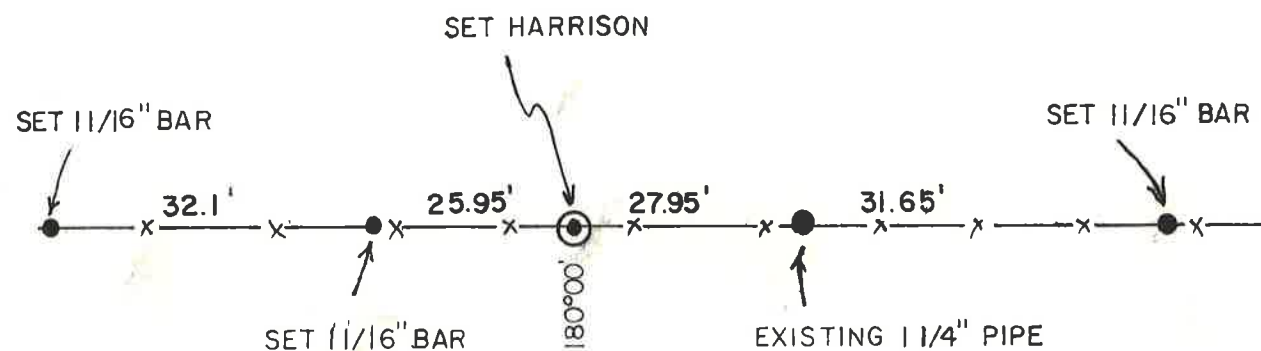

City, Village or Town Wells

County of Monroe

COUNTY SURVEYOR FORM NO. 1