

21604160020

I, Gary L. Dechant, do hereby certify that on the 27th day of March 1986, I found (evidence) (~~no evidence~~) of the S¹/₄ corner of Section 16, T 16 N, R 4 W Fourth Principal Meridian, and I re-established said corner according to the Wisconsin Statutes as shown and described hereon.

Dated this 31st day of March 1986.

Gary L. Dechant


Registered Land Surveyor, 1744
Title

History of corner establishment since Original Government Survey

Although Fred Holden makes no mention of this corner in his notes of Nov. 1906, he was probably here as he did some work along the South line of this section.

Description of corner evidence found:

Set corner by single proportionate measurement.

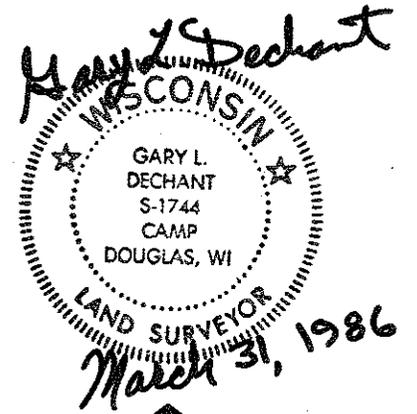

Description of corner and witness monuments, references and accessories used to perpetuate the original or re-established location of this corner:



Sunny & Warm

Witnesses to corner location:

Claire Noble

Gary Dechant

COUNTY SURVEYOR FORM NO. 1

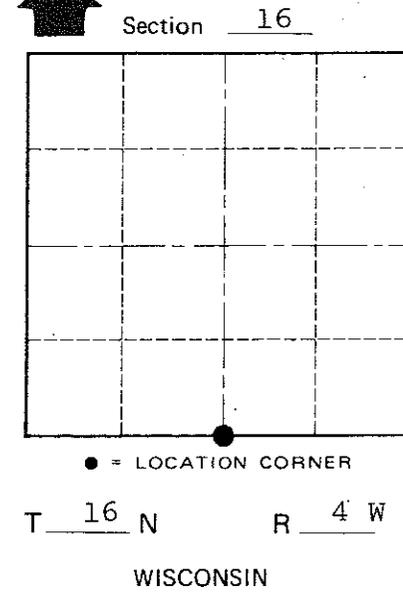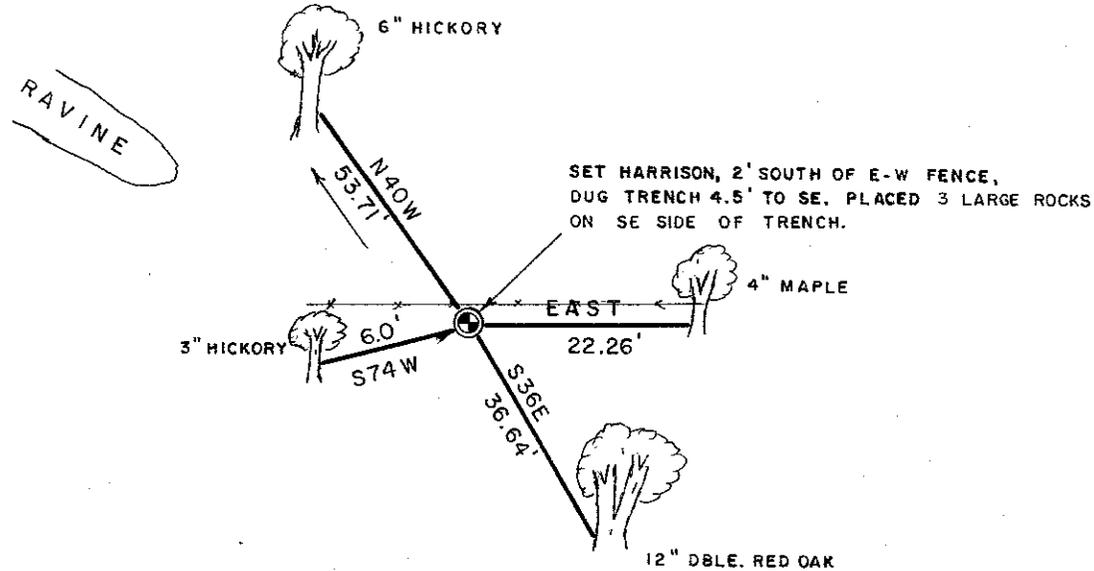

SURVEY CONTROL ORDER

Horizontal _____
Vertical _____

WISCONSIN COORDINATE SYSTEM

Corner	East (X)	North (Y)	Elevation (Z)	Zone
Control Sta. Name				

(Trees double blazed with N&C's set)

City, Village or Town Leon

County of Monroe