


U. S. PUBLIC LAND SURVEY MONUMENT RECORD

SECTION 18 T 16 N, R 4 W, TOWN OF LEON  
MONROE COUNTY

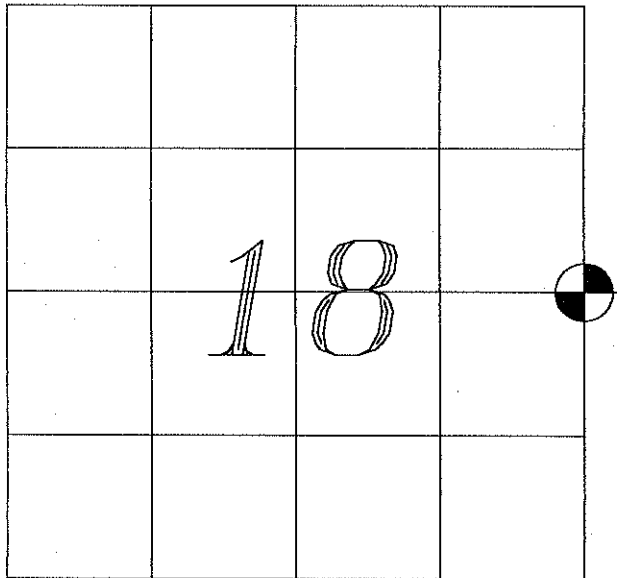

LOCATION OF LANDMARK

WISCONSIN COORDINATE SYSTEM
North
East
Theta Angle
Horiz. Order
Vert. Order

TYPE OF LANDMARK  
HARRISON

BEARINGS ARE REFERENCED TO  
The North line of Section 7  
assumed S 88°33'31" E

CREW: MICHAEL J. HARDING  
SCOTT DUNNUM

DATE: 4-21-99

Describe any record evidence, monument evidence, testimonial evidence, or any other material evidence you considered and whether the monument was found or restored through acceptance of an obliterated evidence location.

No bearing trees were found. I set a Harrison monument equidistant from the northeast corner and the southeast corner in downed fence line. No occupational evidence was found to the East or West.

Describe or show any material discrepancy between the location of the restored corner and that of the corner previously restored or reestablished.

NONE.



*Michael J. Harding*  
4-21-99

