

21605122000

I, Bryan H. Meyer, do hereby certify that on the 8th day of October 1984, I found (evidence) [redacted] of the West 1/4 corner of Section 7, T 16 N, R 4 W Fourth Principal Meridian, and I re-established said corner according to the Wisconsin Statutes as shown and described hereon.

Dated this 15th day of Oct. 1984.

Bryan H. Meyer

Deputy County Surveyor
Title

History of corner establishment since Original Government Survey

Henry I. Bliss, County Surveyor of LaCrosse County, surveyed the entire Township of Bangor, in 1867, and set monuments at each Section and Quarter corner.

Description of corner evidence found:

Found a 6"x6" stone in a North-South fence line. This stone is split in 2 places. This stone is similar to others found on the West line of the Township of Leon, therefore, I accepted the stone as the corner.



COUNTY SURVEYOR FORM NO. 1



Description of corner and witness monuments, references and accessories used to perpetuate the original or re-established location of this corner:

Crew: Wilhite, Lund
Date: October 8, 1984
Weather: Cloudy, 65°±.
Witnesses to corner location:

Dallas Wilhite

James Lund

Note: The bearings shown are magnetic hand compass bearings.

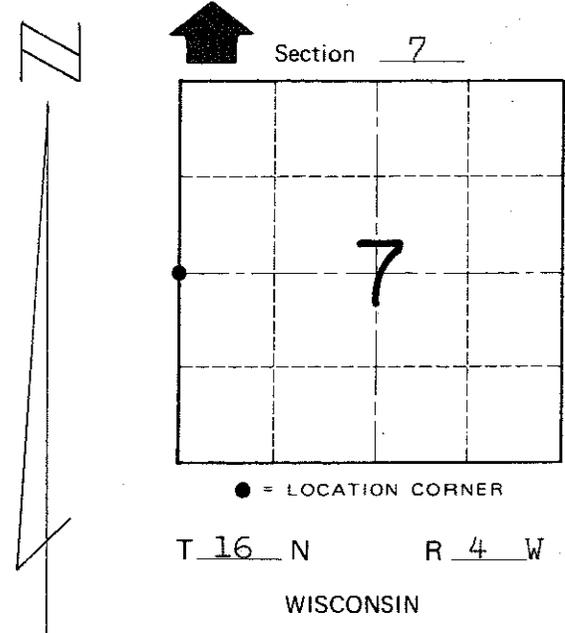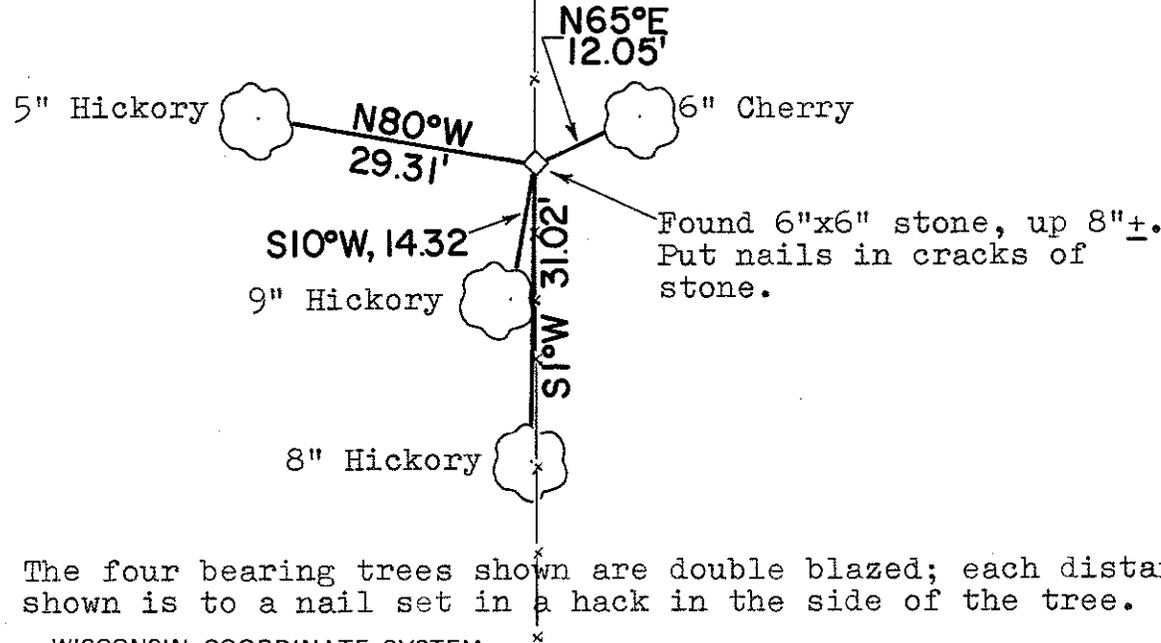

The four bearing trees shown are double blazed; each distance shown is to a nail set in a hack in the side of the tree.

WISCONSIN COORDINATE SYSTEM

SURVEY CONTROL ORDER

Horizontal	_____
Vertical	_____

Corner	East (X)	North (Y)	Elevation (Z)	Zone
Control Sta. Name				

~~City/Village of~~ Town of Leon
County of Monroe