

64


**U.S. PUBLIC LAND CORNER
MAINTENANCE**

**Corner ID : N1/4 Sec.23, T17N-R1W
21701140020**

<u>DATE</u>	<u>CREW</u>	<u>MONUMENT TYPE</u>
November 28, 2018	Zachariah P. Dechant Gary L. Dechant	Existing Harrison, top broke off at remains of fence corner. Down 6". Fenced off garden to SW. Set sign 1' west.

References:

	<u>Bearing</u>	<u>Distance</u>
1) Set 3/4"x24" round iron bar, down 12" in field	N50E	29.00'
2) Set 3/4"x24" round iron bar, down 12" in field	S67E	29.45'
3) Set 3/4"x24" round iron bar, down 12" in field	S70W	25.48'
4) Set 3/4"x24" round iron bar, down 12" in field	N50W	28.08'

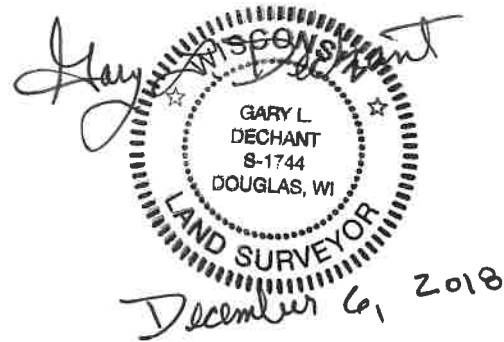

I, Harley A. Sime, do hereby certify that on the 29th day of June 1981, I found (evidence) (~~no evidence~~) of the N $\frac{1}{4}$ corner of Section 23, T 17 N, R 1 W Fourth Principal Meridian, and I re-established said corner according to the Wisconsin Statutes as shown and described hereon.

Dated this 25th day of August 1981.

Harley A. Sime, R.L.S. 355

County Surveyor
Approved: HARLEY A. SIME
MONROE CO. SURVEYOR

Description of corner and witness monuments, references and accessories used to perpetuate the original or re-established location of this corner:

History of corner establishment since Original Government Survey

Schroeder was here in November of 1887.

Description of corner evidence found:

Accepted a fence corner as best available evidence.

**See Reverse Side
For Maintenance**

Witnesses to corner location:

B. Meyer

G. Dechant

NOTE! There were no other ties in the area.



OPEN


SET HARRISON, UP 2"



FIELD

OPEN

O = SET 3/4" x 24" IRON BAR

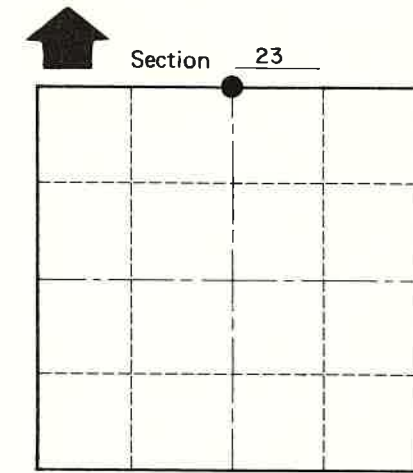

● = LOCATION CORNER

T 17 N R 1 W

WISCONSIN

SURVEY CONTROL ORDER

Horizontal	_____
Vertical	_____

WISCONSIN COORDINATE SYSTEM

Corner	East (X)	North (Y)	Elevation (Z)	Zone
Control Sta. Name				

SICKLY 8" DOUBLE CHERRY
NO NAIL OR BLAZE. DISTANCE TO FACE

City, Village or Town Tomah

County of Monroe

COUNTY SURVEYOR FORM NO. 1