

56


**U.S. PUBLIC LAND CORNER
MAINTENANCE**

**Corner ID : E1/4 Sec. 17, T17N-R1W
21701172000**

DATE	CREW	MONUMENT TYPE -----
September 17, 2018	Zachariah P. Dechant Gary L. Dechant	Found Harrison intact. Set 3 flat stones around Harrison. Set sign 1' N. Corner is 32' east of center of swale. 28' south of power line. 19' south of east-west fence and 26' west of north-south fence.

References:

	<u>Bearing</u>	<u>Distance</u>
1) Set 3/4" x 24" round iron bar, down 4", 4' S & 4' W of fence corner	N60E	28.50'
2) Set 3/4"x 24" round iron bar, down 4", 7' NW of 24" White Oak (1976 BT)	S24E	32.38'
3) Set 3/4"x 24" round iron bar, down 4"	S62W	18.26'
4) Set 3/4"x 24" round iron bar, down 4", 4' south of east-west fence	N30W	17.05'

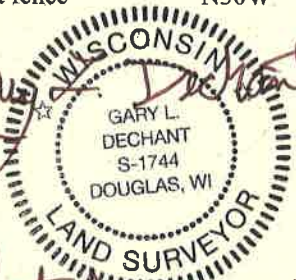Gary L. Dechant

September 17, 2018

I, Harley A. Sime, do hereby certify that on the 4 day of October 19 76, I found (evidence) ~~(no evidence)~~ of the E 1/4 corner of Section 17, T 17 N, R 1 W, Fourth Principal Meridian, and I re-established said corner according to the Wisconsin Statutes as shown and described hereon.

Dated this 6th day of Feb. 19 78.

History of original corner establishment:

Description of corner evidence found:

This corner was set by the State Hwy. Commission surveyors when they surveyed out the State Patrol Hdq.

County Surveyor _____
Title

**Approved: HARLEY A. SIME
MONROE CO. SURVEYOR**




**See Reverse Side
For Maintenance**

Description of corner and witness monuments, references and accessories used to perpetuate the original or re-established location of this corner:

Set Harrison Monument

Witnesses to corner location:

State Hwy. Comm. surveyors

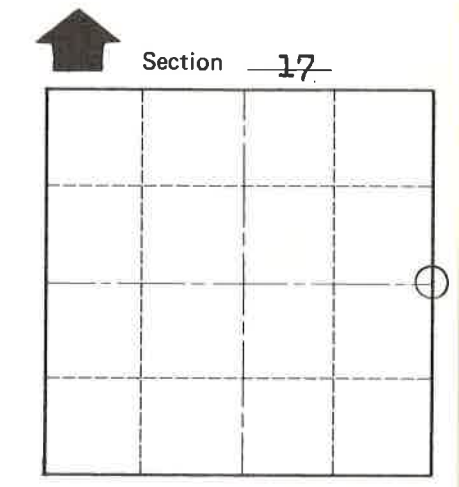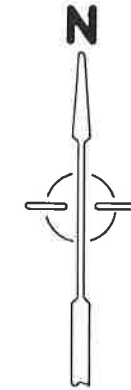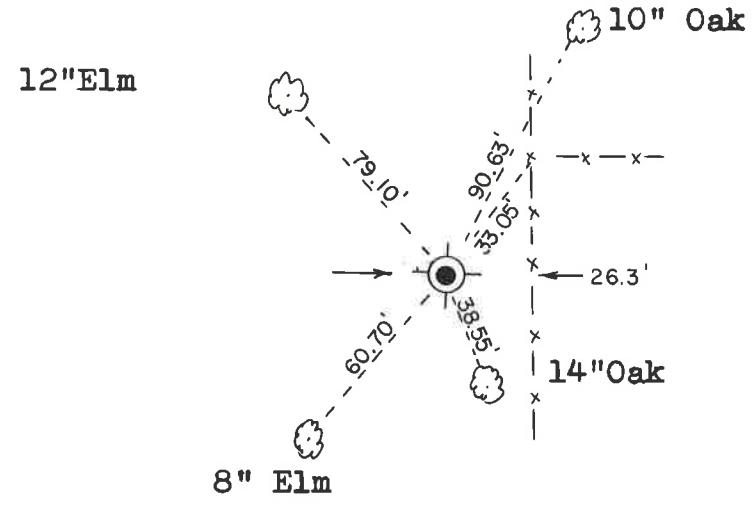

O = LOCATION CORNER
T 17 N R 1 W
WISCONSIN

COUNTY SURVEYOR FORM NO. 1

SURVEY CONTROL ORDER

Horizontal	_____
Vertical	_____

WISCONSIN COORDINATE SYSTEM

Corner	East (X)	North (Y)	Elevation (Z)	Zone
Control Sta. Name				

~~City/Village~~ or Town Tomah
County of Monroe