

CERTIFICATE

CERTIFIED LAND CORNER

No. 36B

21701092020

I, Harley A. Sime, do hereby certify that on the 19th day of May 1980, I found (evidence) ~~(no evidence)~~ of the C¹/₄ corner of Section 9, T 17 N, R 1 W Fourth Principal Meridian, and I re-established said corner according to the Wisconsin Statutes as shown and described hereon.

Dated this 16th day of Jan. 1981.

Harley A. Sime-R.L.S. 355

County Surveyor
Title

History of corner establishment since Original Government Survey

O.R. Dahl was at the Center 1/4 corner in July of 1871.

Description of corner evidence found:

Found a P.K. nail and cap at the Center 1/4 corner. This location has been used as the corner in several previous surveys.

COUNTY SURVEYOR FORM NO. 1



Description of corner and witness monuments, references and accessories used to perpetuate the original or re-established location of this corner:

Witnesses to corner location:

M. Scott Sowers

T. Tormoen

**Approved: HARLEY A. SIME
MONROE CO. SURVEYOR**

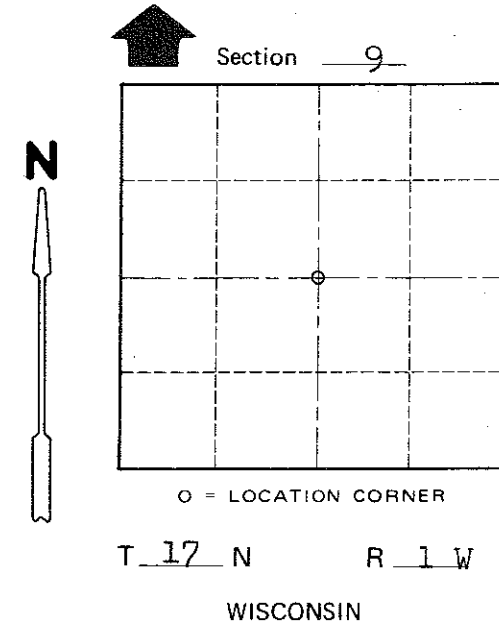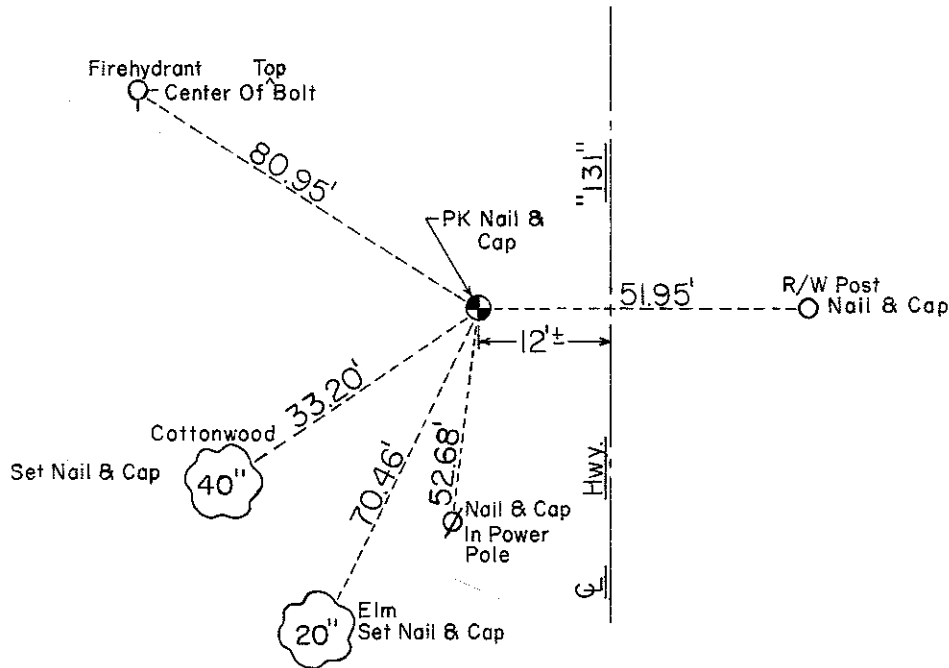

SURVEY CONTROL ORDER

Horizontal	_____
Vertical	_____

WISCONSIN COORDINATE SYSTEM

Corner	East (X)	North (Y)	Elevation (Z)	Zone
Control Sta. Name				

City, Village or Town Tomah

County of Monroe