CERTIFIED LAND CORNER

21702272000

History of original corner establishment:

O.R.Dahl was at this corner in August of 1868.


Description of corner evidence found:

Found standard Harrison monument set at a three-way fence intersection by a previous survey; more than half of the monument was broken off: replaced it with a new Harrison Monument.

Approved: HARLEY A. SIME MONROE CO. SURVEYOR

do hereby

Description of corner and witness monuments, references and accessories used to perpetuate the original or re-established location of this corner:

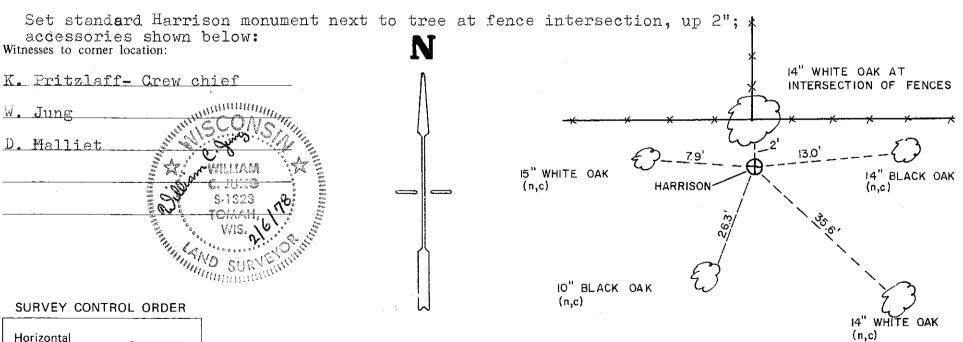

	Section	27	
			-
	.	- 	
	E 		
	<u> </u>		t I
0	= LOCATI	ON COR	NER
T1	Z_ N	R_	2 W

WISCONSIN

/ertical		WISCONSIN COORDINATE SYSTEM				
Corner	East (X)		North (Y)	Elevation (Z)	Zone	
Control Sta. Name		. ,				

i ty, Villago or T own <u>Adrian</u>	
County of Monroe	