History of original corner establishment: None

21702342010

I, <u>Harley A. Sime</u>, do hereby certify that on the <u>5th</u> day of <u>October</u> 19 77, I found (evidence) (no evidence) of the <u>SW core</u> SE¼-NE¼ corner of <u>Section 34</u>, T 17 N, R 2 W, Fourth Principal Meridian, and I reestablished said corner according to the Wisconsin Statutes as shown and described hereon.

Dated this 1 day of <u>Dec.</u> 1977.

Description of corner evidence found:

Set this corner on line and half way between the center of the Section and the east quarter corner.

County Surveyor Approved: HARLEY A. SIME


Description of corner and witness monuments, references and accessories used to perpetuate the original or re-established location of this corner:


Set a 3/4" x 24" Iron Bar.

Witnesses to corner location:

Pietz

Trees blazed and nail & cap set

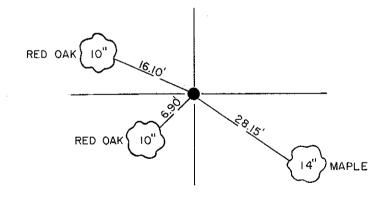

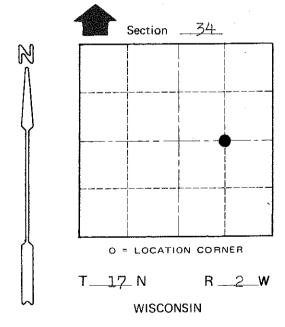

SURVEY CONTROL ORDER

110(120)(tal					
Vertical		WISCONSIN COORDINATE SYSTEM			
	East (X)	North (Y)	Elevation (Z)	Zone	
Corner					
Control Sta. Name					

City, Village or <u>Town</u>	Adrian
County of _	Monroe
	Wisconsin