

CERTIFICATE

CERTIFIED LAND CORNER

No. 117B

21702342020

I, Harley A. Sime, do hereby certify that on the 21 day of October 1977, I found ~~(none)~~ (no evidence) of the Center 1/4 corner of Section 34, T 17 N, R 2 W, Fourth Principal Meridian, and I re-established said corner according to the Wisconsin Statutes as shown and described hereon.

History of original corner establishment: None

Dated this 3 day of Nov. 1977.

Description of corner evidence found:

Set this corner by intersecting the North-South and East-West quarter lines.


County Surveyor Approved: HARLEY A. SIME
Title
MONROE CO. SURVEYOR

COUNTY SURVEYOR FORM NO. 1


Description of corner and witness monuments, references and accessories used to perpetuate the original or re-established location of this corner:

Set 3/4" x 24" round iron bar.
 All trees blazed, with nail and caps
 Witnesses to corner location:

Pietz
Lueck
Dechant

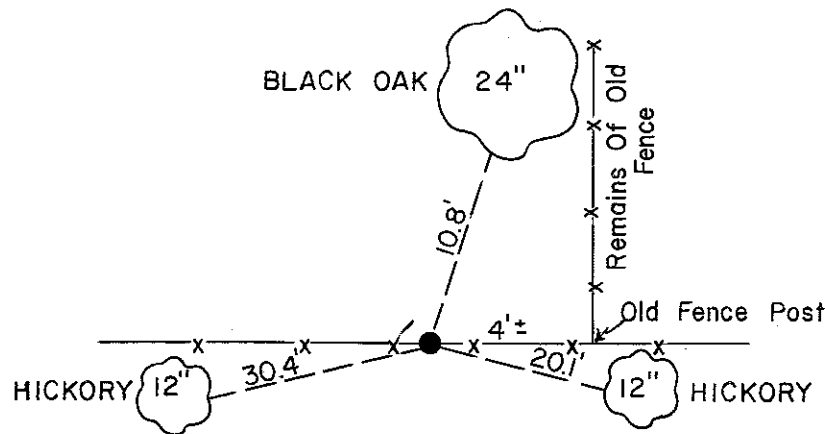

Trees blazed and nail and cap set.

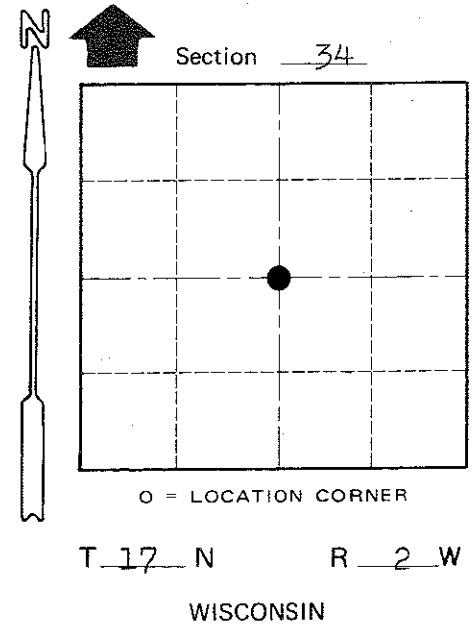

SURVEY CONTROL ORDER

Horizontal	_____
Vertical	_____

WISCONSIN COORDINATE SYSTEM

Corner	East (X)	North (Y)	Elevation (Z)	Zone
Control Sta. Name				

City, Village or Town Adrian

County of Monroe