


MAINTENANCE- PUBLIC LAND SURVEY MONUMENT RECORD


TIE SHEET UPDATE-21705010000 (LA CROSSE COUNTY INDEX 27H)

2011-52

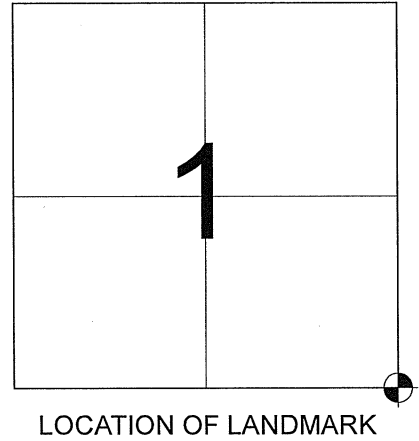

Pete Follansbee and I performed maintenance work on this corner on August 3, 2011. We found the Harrison marker of record at the corner at a fence intersection. We found 3 of H. Sime's ties and established 3 new nails and 1 new tie as shown below.

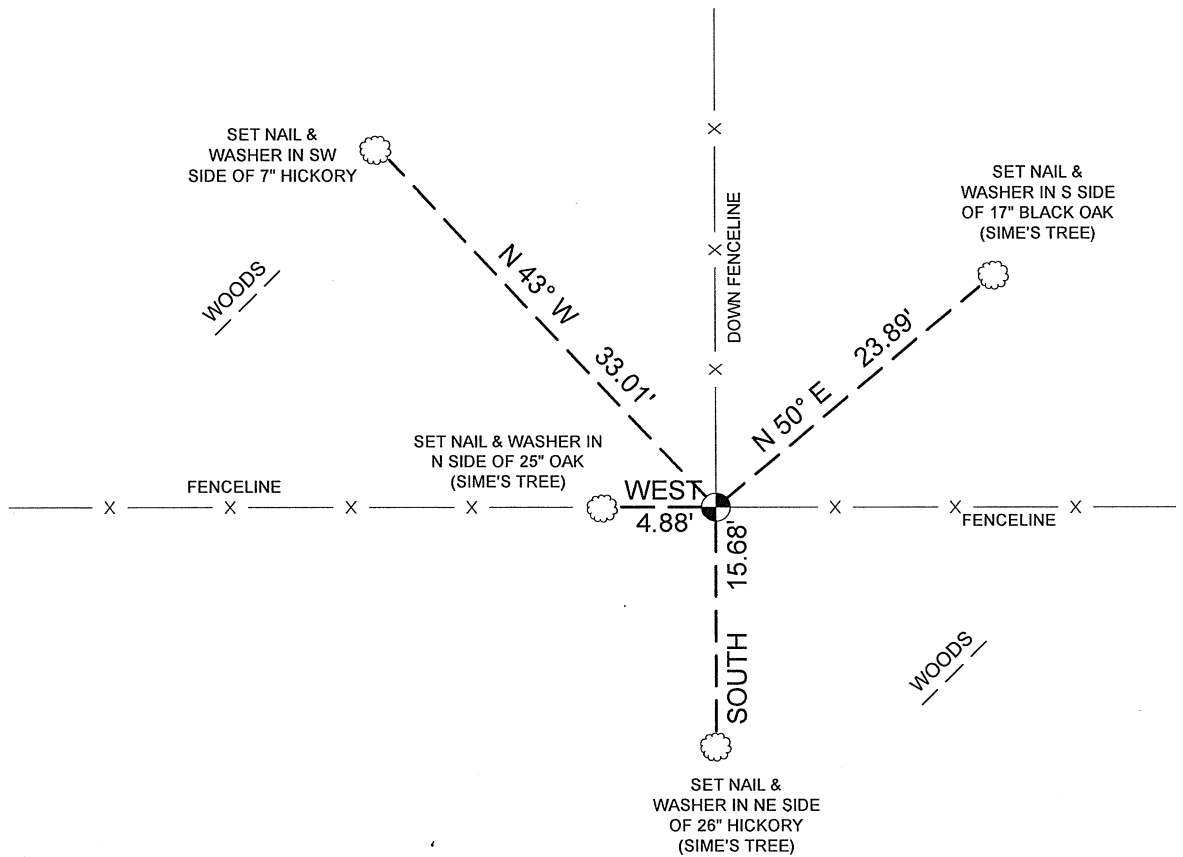



SSP 2' NORTH OF CORNER FACING SOUTH



LEGEND

-  HARRISON MARKER
-  TREE AS DESCRIBED

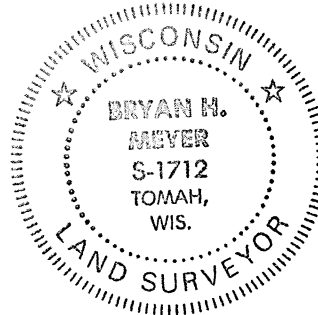

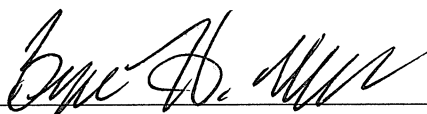
 Bryan H. Meyer
 La Crosse County Surveyor

8/11/2011
 Date

CORNER ID:
 21705010000

CERTIFICATE

CERTIFIED LAND CORNER

No. 33

21705010000

I, Harley A. Sime, do hereby certify that on the 26 day of March 1975, I found ~~(evidence)~~ (no evidence) of the S.W. corner of Section 6, T 17 N, R 4 W, Fourth Principal Meridian, and I re-established said corner according to the Wisconsin Statutes as shown and described hereon.

History of original corner establishment:

Description of corner evidence found:

Dated this 14 day of Jan. 1976.

Accepted an old and well occupied 4-way fence corner as the best available evidence. See corner sheet #32 for further information on the closing line to the East. No further evidence could be found to the West. This corner fits the West line of the Township fairly well.




Harley A. Sime
County Surveyor
Title

The terrain North and East is very rugged.



Description of corner and witness monuments, references and accessories used to perpetuate the original or re-established location of this corner:
Set a Harrison marker in the fence corner, up 6".

Witnesses to corner location:

W.C. Jung - Crew Chief W.C. Jung
D. Malliet
A. Lueck

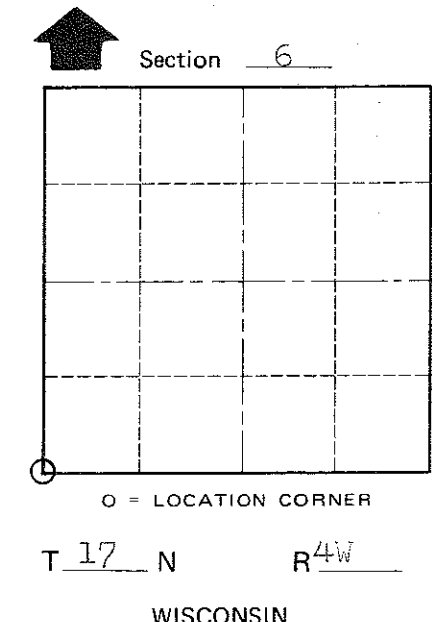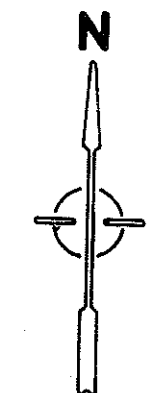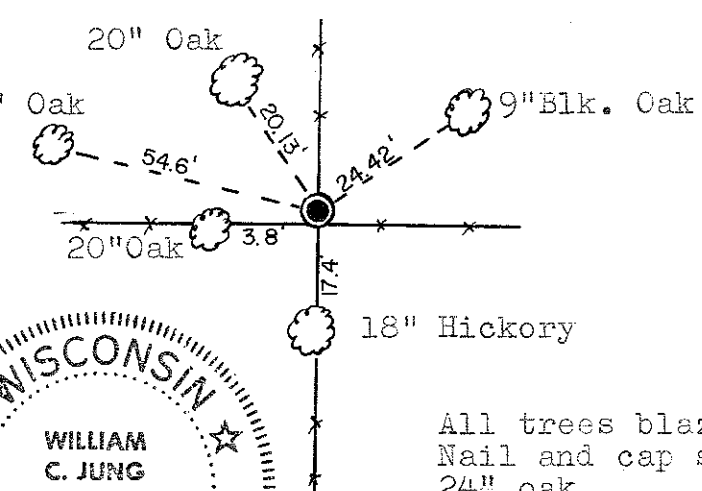

All trees blazed and Nail and cap set except 24" oak.

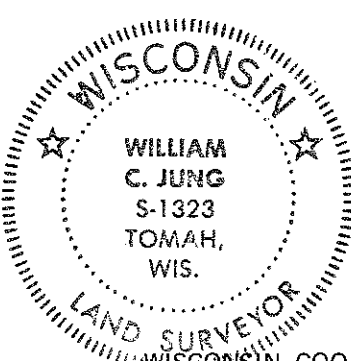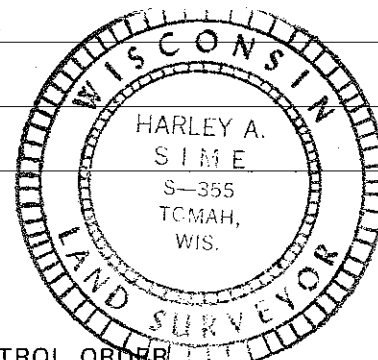

COUNTY SURVEYOR FORM NO. 1

SURVEY CONTROL ORDER

Horizontal				
Vertical				
Corner	East (X)	North (Y)	Elevation (Z)	Zone
Control Sta. Name				

City, Village or Town Sparta
County of Monroe