

77

**U.S. PUBLIC LAND CORNER
MAINTENANCE**

**Corner ID : E1/4 Sec. 21, T17N-R4W
21704212000**

<u>DATE</u>	<u>CREW</u>	<u>MONUMENT TYPE</u>
November 21, 2018	Zachariah P. Dechant Gary L. Dechant	Found Harrison, intact, 2.5' west & 1' south of NW corner of shed. 45' east of 7013 Hamlet drivethru driveway from Hamlet to STH "16".

<u>References:</u>	<u>Bearing</u>	<u>Distance</u>
1) Set 3/4"x 24" round iron bar, flush in lawn, 2' north of NW corner of shed with stone foundation	N34E	3.70'
2) Set 1/4" x 24" round iron bar, 2' west of SW corner of shed with stone foundation	S2E	20.86'
3) Set 3/4"x 24" round iron bar, in lawn, 2' north of NE corner of red pole building	S58W	66.76'
4) Set 1/4" x 24" round iron bar 2' south of SW corner of small wood shed	N42W	16.97'

Gary L. Dechant

November 21, 2018

CERTIFICATE

CERTIFIED LAND CORNER

No. 77

I, Harley A. Sime, do hereby certify that on the 20th day of January 1976, I found ~~(evidence)~~ (no evidence) of the E 1/4 corner of Section 21, T 17 N, R 4 W Fourth Principal Meridian, and I re-established said corner according to the Wisconsin Statutes as shown and described hereon.

Dated this 22nd day of Jan. 1976.

Harley A. Sime
County Surveyor
Title

History of original corner establishment:

See Reverse Side For Maintenance

Description of corner evidence found:




A 1 1/2" iron pipe was found that had been used as the 1/4 corner by Duane Marten in a previous certified survey. An old local farmer said the pipe had been there over 30 years. He didn't know how it had got there though. The pipe was not on record, no other surveys were tied to it besides Marten's, nor could we find any information about it on old highway R/W maps or in old deeds in the courthouse. Aerial photos, evidence in Section 21, and information from an 1895 survey by Henry Schroeder showed that the corner should move North. Using the latter points, the corner was moved North to its present position. The iron pipe was removed to avoid future confusion. Ties for its old position are also shown below.

Description of corner and witness monuments, references and accessories used to perpetuate the original or re-established location of this corner:

Set a 3/4"x24" iron bar, up 3", 210± feet South of the centerline of old Highway "16" and 42.13 feet North of the position of the removed iron pipe.


Witnesses to corner location:

W.C. Jung - Crew Chief
G. Sime

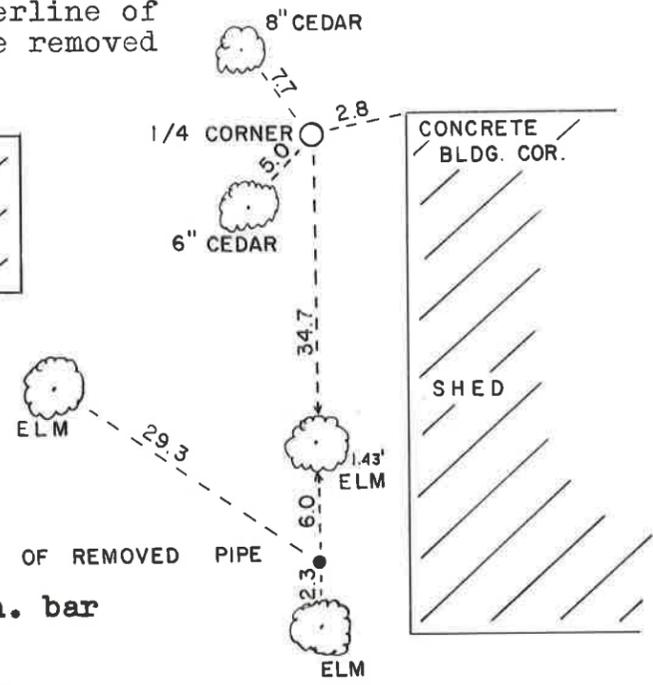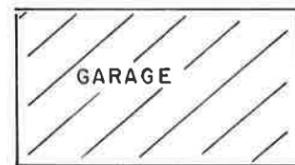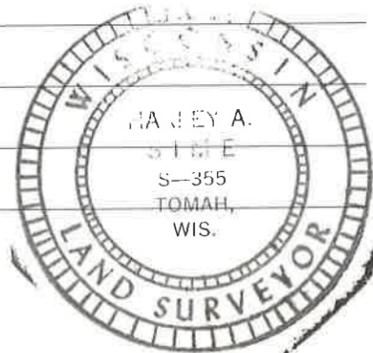

Note: The elms used as ties for the pipe have nails and caps in them.

POSITION OF REMOVED PIPE

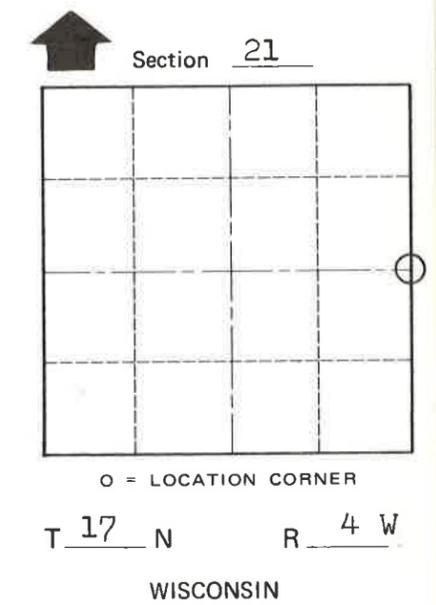


SURVEY CONTROL ORDER

Horizontal _____
Vertical _____

IMPORTANT! 6/4/76 - Replaced the 3/4in. bar with a Harrison marker.
Crew - Jung, Dechant
WISCONSIN COORDINATE SYSTEM

Corner	East (X)	North (Y)	Elevation (Z)	Zone
Control Sta. Name				

City, Village or Town Sparta
County of Monroe

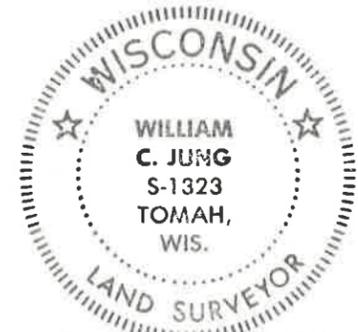

COUNTY SURVEYOR FORM NO. 1