

MAINTENANCE- PUBLIC LAND SURVEY MONUMENT RECORD

TIE SHEET UPDATE-21705362000 (LA CROSSE COUNTY INDEX 156H)

Pete Follansbee and I performed maintenance work on this corner on August 15, 2011. We found the Harrison marker of record at the corner in the centerline. We didn't find any of H. Sime's ties and established 4 new ties as shown below.

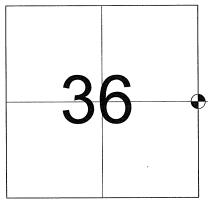

LOCATION OF LANDMARK

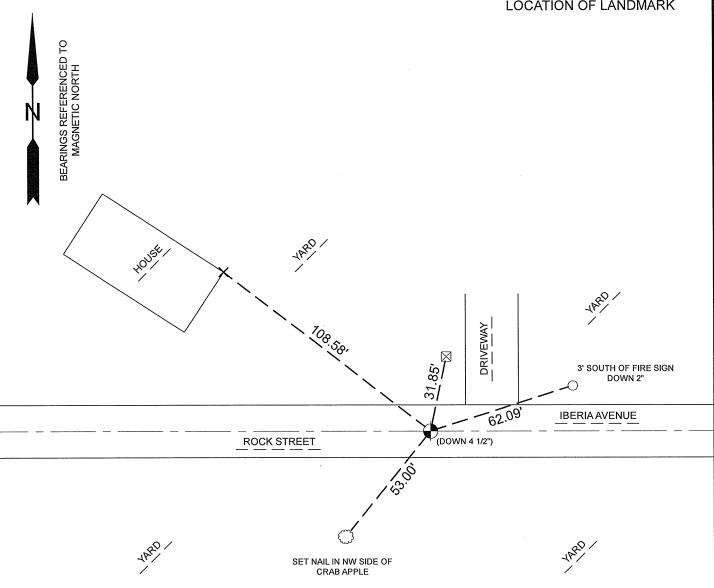

LEGEND



HARRISON MARKER

- **GAS VALVE**
- 0 SET 3/4"X24" IRON REBAR (1.50lbs/ft)
- TREE AS DESCRIBED
- CONCRETE FOUNDATION CORNER

Bryan H. Meyer

La Crosse County Surveyor

CORNER ID: 21705362000

A 1 -	3.3	L
No.	فالمل الماليات	

History of original corner establishment:

2 1	7	П5	36	52	\Box	חר

I, Harley A. Sime , do hereby certify that on the 22 day of October 19 75, I found (evidence) (no evidence) of the W 1/4 corner of Section 31 , T 17 N, R 4W Fourth Principal Meridian, and I reestablished said corner according to the Wisconsin Statutes as shown and described hereon.

Dated this 5 day of March 1976.

County Surveyor

Corner

Control Sta. Name

Description of corner evidence found:

Accepted the existing field conditions. By the aerial photo, the centerline of the road at this location matched well with the quarterline fence to the East. The ½ mile distance to the C¼ corner, Sec. 36, T17N-R5W (existing 2" iron pipe) fit reasonably well. The North-South fence at the corner is in fair condition. I placed the corner at the intersection of the fence extended and the centerline of the road.

County of ___Monroe_

Description of corner and witness monuments, references and accessories used to perpetuate the original or re-established location of this corner: Section 31 Set Harrison monument, down 2" Harrison down 2" "LaCrosse County" Witnesses to corner location: Dauglas & Malliet sign D.J. Malliet - Crew Chief, Reg. Survyeor 3/4"Bar A. Lueck Power Pole Power Pole HARLEY A 5---355 O = LOCATION CORNER R 4W T 17 N 8"x6%"Wood fence n&c in power poles post with n&c WISCONSIN MONRO SURVEY CONTROL ORDER Horizontal WISCONSIN COORDINATE SYSTEM Vertical City, Village or Town ___ Sparta North (Y) Zone East (X) Elevation (Z)