

16

U.S. PUBLIC LAND CORNER MAINTENANCE


Corner ID : W1/4 Sec. 4, T18N-R1E

41801052000

DATE	CREW	MONUMENT TYPE -----
February 7, 2018	Zachariah P.Dechant Gary Dechant	Found 2" iron pipe in bad shape. Replaced with a 3/4"x6" round iron bar. Fits BT to NW 36.35' called as a double White Oak actually a red oak. Corner falls on west side of Dead Creek. Set survey sign on east berm of Dead Creek west of Copper Road

References:

	<u>Bearing</u>	<u>Distance</u>
1) Set 3/4"x24" round iron bar, 4' SW of 14" Red Pine, 31' east of Road	N52°16'15"E	146.30'
2) Set 3/4"x24" round iron bar, 4' East of 12" Dble Black Oak, 50' east of Road	S51°00'00"E	172.30'
3) Set 3/4"x24" round iron bar, on top of west berm, 3' South of 6" White Pine	S52°16'15"W	13.09'
4) Set 3/4"x24" round iron bar, on top of west berm, 13' north of 6" White Pine	N51°00'00"W	14.87'

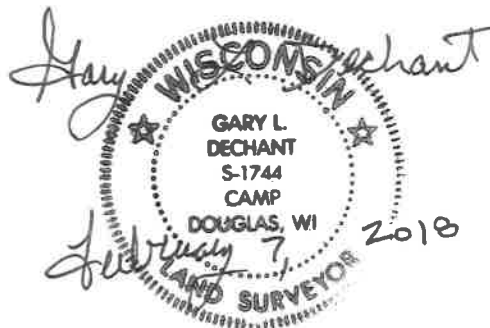

41801052000

I, Harley A. Sime, do hereby certify that on the eleventh day of July 1980, I found ~~(evidence)~~ (no evidence) of the West 1/4 corner of Section 4, T18 N, R1E Fourth Principal Meridian, and I re-established said corner according to the Wisconsin Statutes as shown and described hereon.

History of corner establishment since Original Government Survey
Holden was at this corner in January of 1903.

Description of corner evidence found:

Set an iron pipe at the corner on line between the section corners and at a distance proportionate to the original government notes.

Dated this 25th day of Feb. 1981.

Harley A. Sime - R.L.S. 355

County Surveyor - Monroe County, Wisconsin.



COUNTY SURVEYOR FORM NO. 1

Description of corner and witness monuments, references and accessories used to perpetuate the original or re-established location of this corner:

Witnesses to corner location:

Scott Sowers

Todd Tormoen

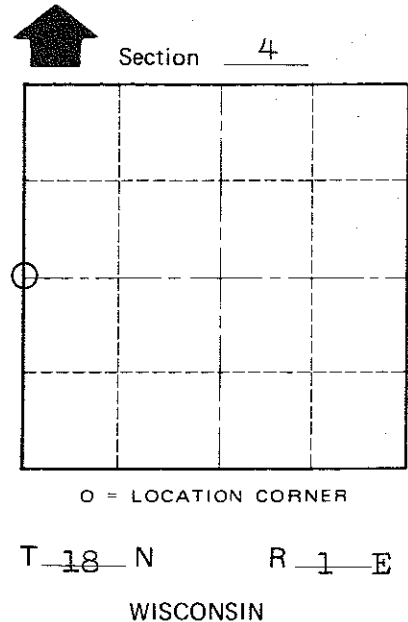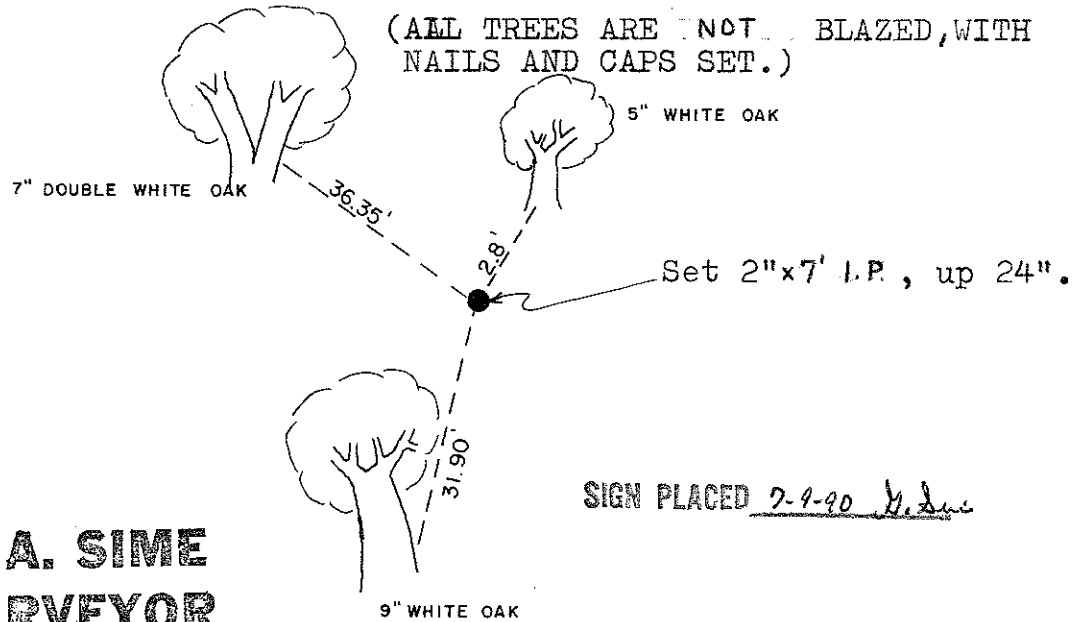

**Approved: HARLEY A. SIME
MONROE CO. SURVEYOR**

SURVEY CONTROL ORDER

Horizontal	_____
Vertical	_____

WISCONSIN COORDINATE SYSTEM

Corner	East (X)	North (Y)	Elevation (Z)	Zone
Control Sta. Name				

~~City, Village or~~ Town of Byron
County of Monroe
Wisconsin.